

HARRISON  
N84  
10-72

MISSISSIPPI  
BOARD OF WATER COMMISSIONERS  
416 North State Street  
Jackson, Mississippi 39201

WATER WELL DRILLERS LOG

*Mc Lee Well Works Harrison*

19 \_\_\_\_\_  
date well completed

firm name

county well located

LANDOWNER: *Houston*  
*Paroliney*  
*Gen. Del.*

description of formations encountered

from to

*Delisle, Ms.*  
(mailing address)

*top soil*

0 2

WELL LOCATION:

sec. 8 T. 8 N R. 13 E  
5 miles N of San Christian  
(distance) (direction) (nearest town)

*course sand*

2 18

WELL PURPOSE: *Home*  
(home, irrigation, municipal, industrial)

*fine sand*

18 62

WELL COMPLETION DATA:

(1) diameter (inches) 2"  
(2) total depth (feet) 545'  
(3) static water level (feet) \_\_\_\_\_  
top of ground. below above  
(4) casing gal. 535'  
(material) (depth)

*gravel*

62 97

*clay*

97 302

*fine sand*

302 387

*clay*

387 476

*course sand*

476 545

\_\_\_\_\_ If telescope see back.  
(size)

(5) screen 10'  
(length) (depth to top)

2"  
(size) (material)

(6) pump 1 18  
(HP) (yield gpm)

Electric  
(type power)

(7) electric log NO  
(yes or no)


NO  
(organization running log)

(8) how well bottom plugged sand  
shark

DRILLERS REMARKS:

If well telescopes please  
sketch and show depths.

**GROUND LEVEL**

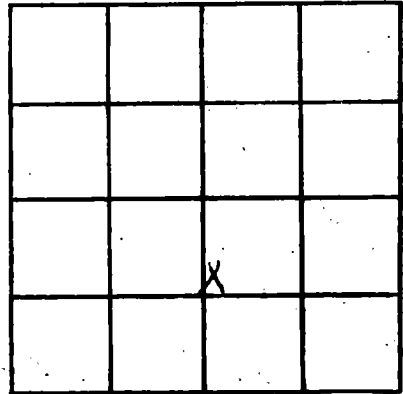

**SECTION** 8

**Please indicate well location X.**

**ADDITIONAL INFORMATION**

If more than one screen,  
show locations of each on sketch.