

**HARRISON**  
**N 85**  
**5-4-72**

MISSISSIPPI  
 BOARD OF WATER COMMISSIONERS  
 416 North State Street  
 Jackson, Mississippi 39201

**CODED**

**WATER WELL DRILLERS LOG**


May 4 1972 McNeil Well Works Harrison  
 date well completed firm name county well located

LANDOWNER: <u>Harold Sellier</u>	description of formations encountered	from	to
<u>Gen. Del.</u>			
<u>Delisle Miss.</u> (mailing address)	<u>topsoil</u>	0	2
	<u>clay</u>	2	18
WELL LOCATION: sec. <u>9</u> T. <u>8</u> N R. <u>13</u> E <u>7</u> miles <u>N</u> of <u>Free Christab</u> (distance) (direction) (nearest town)	<u>course sand</u>	18	96
	<u>clay</u>	96	182
WELL PURPOSE: <u>Home</u> (home, irrigation, municipal, industrial)	<u>fine sand</u>	182	214
WELL COMPLETION DATA:	<u>clay</u>	214	347
(1) diameter (inches) <u>2"</u>	<u>fine sand</u>	347	361
(2) total depth (feet) <u>585'</u>	<u>Blue clay</u>	361	477
(3) static water level (feet) <u>1 1/4</u> <u>in</u> below top of ground.	<u>fine sand</u>	477	502
(4) casing <u>gal</u> <u>525'</u> (material) (depth)	<u>course sand</u>	502	535
(size) If telescope see back.			
(5) screen <u>10'</u> (length) (depth to top)			
<u>2"</u> <u>5.5</u> (size) (material)			
(6) pump <u>1</u> <u>12</u> (HP) (yield gpm)			
<u>electric</u> (type power)			
(7) electric log <u>no</u> (yes or no)			
(organization running log)			
(8) how well bottom plugged <u>sand</u> <u>shark</u>			
DRILLERS REMARKS:			

**CODED**

If well telescopes please sketch and show depths.

GROUND LEVEL

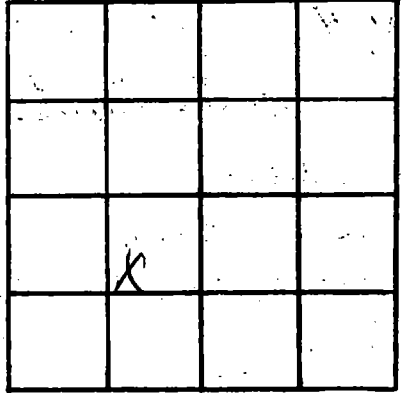

SECTION 9

Please indicate well location X.

ADDITIONAL INFORMATION

If more than one screen, show locations of each on sketch.