

HARRISON
N 87
5-1-72

MISSISSIPPI
 BOARD OF WATER COMMISSIONERS
 416 North State Street
 Jackson, Mississippi 39201

CODED

WATER WELL DRILLERS LOG

May 1 19 72 Mc Gill well works Harrison
 date well completed firm name county well located

LANDOWNER:
Fred Scarborough
Pass Christain, Miss
 (mailing address)

description of formations encountered	from	to
<u>topsoil</u>	<u>0</u>	<u>3</u>
<u>clay</u>	<u>3</u>	<u>18</u>
<u>Coarse sand</u>	<u>18</u>	<u>69</u>
<u>Blue gummy clay</u>	<u>69</u>	<u>521</u>
<u>sand 1-coburcel</u>	<u>521</u>	<u>572</u>

WELL LOCATION:
 sec. 6 T 8 N R 13 E
S W
1 miles west of Delisle
 (distance) (direction) (nearest town)

WELL PURPOSE: Home
 (home, irrigation, municipal, industrial)


- WELL COMPLETION DATA:**
- (1) diameter (inches) 2"
 - (2) total depth (feet) 572'
 - (3) static water level (feet) 2 1/2" below top of ground.
 - (4) casing Gal. 562'
 (material) (depth)
 - if telescope see back.
 (size)
 - (5) screen 10"
 (length) (depth to top)
 - 2" plastic
 (size) (material)
 - (6) pump 1 13
 (HP) (yield gpm)
 - electric
 (type power)
 - (7) electric log no
 (yes or no)
 - (organization running log)
 - (8) how well bottom plugged sand
shark

CODED

DRILLERS REMARKS:

If well telescopes please sketch and show depths.

GROUND LEVEL

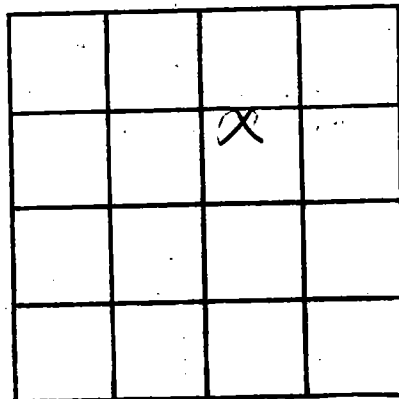

SECTION 6

Please indicate well location X.

ADDITIONAL INFORMATION

If more than one screen, show locations of each on sketch.