

MISSISSIPPI
BOARD OF WATER COMMISSIONERS
416 North State Street
Jackson, Mississippi 39201

CODED

WATER WELL DRILLERS LOG

HARRISON
N89
3-19-73


3-19-73 19 Sutter Well Works Harrison
date well completed firm name county well located

LANDOWNER: <u>Julia LaRosee</u>	description of formations encountered	from	to
<u>349 Homestead Ave.</u>			
<u>Metairie, La. 70005</u> (mailing address)	Sand	0	12
	Clay	12	26
	Sand	26	78
WELL LOCATION: <u>Henderson Pt.</u>	Clay	78	165
sec. <u>28</u> T <u>8</u> R <u>13</u>	Clay-sand streaks	165	290
<u>1</u> miles <u>W</u> of <u>Pass Christian</u>	Sand	290	333
(distance) (direction) of (nearest town)			
WELL PURPOSE: <u>home</u> (home, irrigation, municipal, industrial)			
WELL COMPLETION DATA:			
(1) diameter (inches) <u>2"</u>			
(2) total depth (feet) <u>333'</u>			
(3) static water level (feet) <u>0</u> below above top of ground.			
(4) casing <u>galv.</u> <u>323'</u> (material) (depth)			
<u>2"</u> (size) If telescope see back.			
(5) screen <u>10'</u> <u>323'</u> (length) (depth to top)			
<u>2"</u> <u>stainless steel</u> (size) (material)			
(6) pump <u>owner's</u> (HP) (yield gpm)			
<u>elec.</u> (type power)			
(7) electric log <u>no</u> (yes or no)			
<u>(organization running log)</u>			
(8) how well bottom plugged <u>B.P. Valve</u>			
DRILLERS REMARKS: <u></u>			

CODED

If well telescopes please sketch and show depths.

GROUND LEVEL

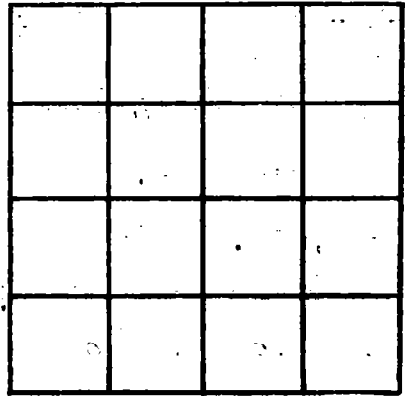

SECTION _____

Please indicate well location X.

ADDITIONAL INFORMATION

If more than one screen, show locations of each on sketch.