

HARRISON
 N90
 3-6-72

MISSISSIPPI
 BOARD OF WATER COMMISSIONERS
 416 North State Street
 Jackson, Mississippi 39201

CODED

WATER WELL DRILLERS LOG

6-march 1972 *Mc Gill Well works* *Harrison*
 date well completed firm name county well located

LANDOWNER: *Max Koberstein*
Hun. Del.
Rose Christian Miss.
 (mailing address)

description of formations encountered

from to

<i>clay</i>	<i>0</i>	<i>22</i>
<i>white sand</i>	<i>22</i>	<i>30</i>
<i>gravel</i>	<i>30</i>	<i>60</i>
<i>white sand</i>	<i>60</i>	<i>81</i>
<i>coarse sand & gravel together</i>	<i>81</i>	<i>97</i>

WELL LOCATION:

sec. 8 T. 8 N. R. 13 E
 S W
6 miles N.W. of P.C.
 (distance) (direction) (nearest town)

WELL PURPOSE:

(home, irrigation, municipal, industrial)

WELL COMPLETION DATA:

- (1) diameter (inches) 2"
- (2) total depth (feet) 97'
- (3) static water level (feet) 3' below above top of ground.
- (4) casing plastic 87'
 (material) (depth)
 If telescope see back.
 (size)
- (5) screen 16'
 (length) (depth to top)
2" plastic
 (size) (material)
- (6) pump 1 9
 (HP) (yield gpm)
Electric
 (type power)
- (7) electric log no
 (yes or no)

(organization running log)

(8) how well bottom plugged sand
mark

CODED


MAY 29 1973

DRILLERS REMARKS:

MISS. Bd. OF
 WATER COMM.

If well telescopes please sketch and show depths.

GROUND LEVEL

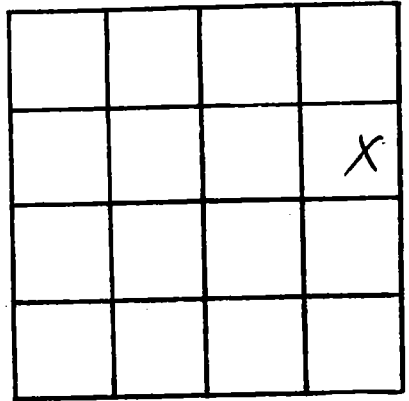

SECTION 8

Please indicate well location X.

ADDITIONAL INFORMATION

A series of horizontal lines for writing additional information.

If more than one screen, show locations of each on sketch.