

452-4988
 HARRISON
 N 92
 7-23-73

MISSISSIPPI
 BOARD OF WATER COMMISSIONERS
 416 North State Street
 Jackson, Mississippi 39201

CODED

WATER WELL DRILLERS LOG

June 15 1971 McGill Well Works Harrison
 date well completed firm name county well located


LANDOWNER: <u>Miss Summaury</u> <u>521 St. Louis</u>	description of formations encountered	from	to
<u>Pass Christian Miss.</u> (mailing address)	<u>clay</u>	<u>0</u>	<u>3</u>
WELL LOCATION: sec. <u>22</u> T. <u>8</u> N. R. <u>13</u> E <u>1</u> miles <u>E</u> of <u>Pass Christian</u> (distance) (direction) (nearest town)	<u>fine sand</u>	<u>3</u>	<u>31</u>
WELL PURPOSE: <u>Irrigation</u> (home, irrigation, municipal, industrial)	<u>slay</u>	<u>31</u>	<u>36</u>
WELL COMPLETION DATA:	<u>course sand</u>	<u>36</u>	<u>60</u>
(1) diameter (inches) <u>1 1/4"</u>			
(2) total depth (feet) <u>60'</u>			
(3) static water level (feet) <u>3'</u> below top of ground.			
(4) casing <u>gal.</u> <u>50'</u> (material) (depth)			
_____ if telescope see back. (size)			
(5) screen <u>10</u> _____ (length) (depth to top)			
<u>1 1/4"</u> <u>5.5</u> (size) (material)			
(6) pump <u>1</u> <u>12</u> (HP) (yield gpm)			
<u>Electric</u> (type power)			
(7) electric log <u>no</u> (yes or no)			
_____ (organization running log)			
(8) how well bottom plugged <u>plug</u>			
DRILLERS REMARKS: _____			

CODED

JUL 13 1973

If well telescopes, please sketch and show depths.

GROUND LEVEL

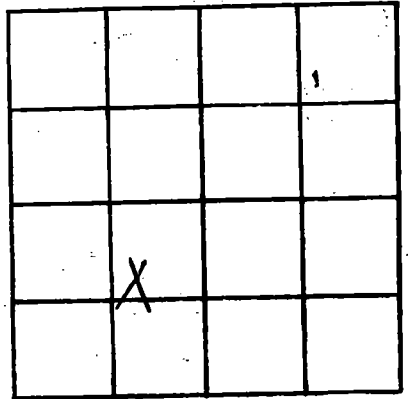

SECTION 22

Please indicate well location X.

ADDITIONAL INFORMATION

If more than one screen, show locations of each on sketch.