

Harrison
 N 93
 8-30-73

MISSISSIPPI
 BOARD OF WATER COMMISSIONERS
 416 North State Street
 Jackson, Mississippi 39201
 WATER WELL DRILLERS LOG

CODED

8-30 1973 Switzer Well Company Harrison
 date well completed firm name county well located

LANDOWNER: Herman Nislet

description of formations encountered from to

(mailing address)

WELL LOCATION:
 sec. 3 T 8 R 13
 3 miles N. of Pass Christian
 (distance) (direction) (nearest town)

Clay 0 29
 sand 29 129
 Clay 129 215
 sand 215 225

WELL PURPOSE: home
 (home, irrigation, municipal, industrial)

WELL COMPLETION DATA:

- (1) diameter (inches) 2"
- (2) total depth (feet) 725'
- (3) static water level (feet) 35' below top of ground
- (4) casing galv. 725' (material) (depth)
 4" (size) if telescope see back.
- (5) screen 20' 705' (length) (depth to top)
 008 stainless steel (size) (material)
 owners
- (6) pump (HP) (yield gpm)
 (type power)
- (7) electric log no (yes or no)
 (organization running log)

clay 225 239
 str. 239 249
 clay 249 254
 sand 254 274
 Clay 274 334
 sand 334 346
 clay 346 437
 str. 437 447
 clay 447 457
 sand 457 479
 clay 479 501
 sand 501 511
 clay 511 526
 str. 526 538
 clay 538 550
 sand 550 558
 fine sand 558 578
 good sand 578 586
 clay 586 598
 clay + shal 598 618
 clay 618 630
 sand 630 638
 good sand 638 725

CODED


SEP 21 1973

MISS. DIV. OF
 WATER CONTROL

DRILLERS REMARKS:

If well telescopes please sketch and show depths.

GROUND LEVEL

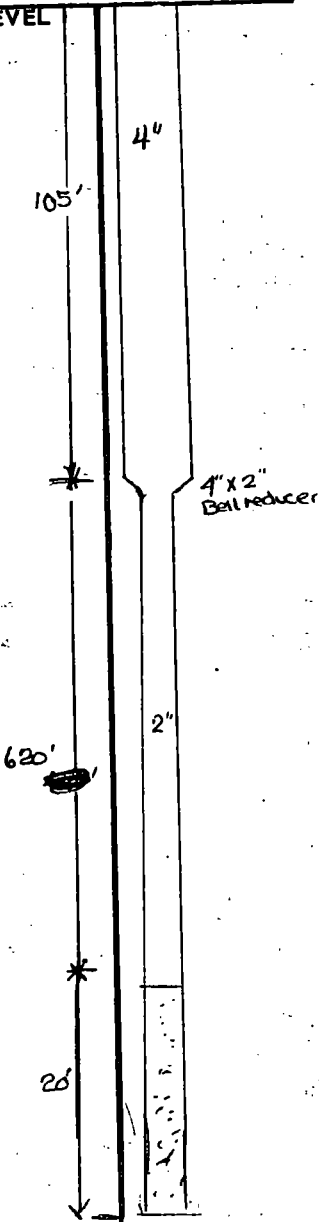

		*	

SECTION 3

Please indicate well location X.

ADDITIONAL INFORMATION

If more than one screen, show locations of each on sketch.