

HARRISON  
N94  
10-24-73

MISSISSIPPI  
BOARD OF WATER COMMISSIONERS  
416 North State Street  
Jackson, Mississippi 39201

CODED N94

WATER WELL DRILLERS LOG

10-24-73 date well completed      R. J. Moore firm name      HARRISON county well located

LANDOWNER: <u>DAVID NOLET</u> <u>RT 1 Box 90</u>	description of formations encountered	from	to
PASS CHRISTIAN MISS (mailing address)	TOP SOIL	0	10
WELL LOCATION: sec. <u>4</u> T. <u>8</u> N. R. <u>13</u> E. <u>2</u> miles <u>W</u> of <u>Dalshire</u> (distance) (direction) (nearest town)	Red clay + sand	10	100
WELL PURPOSE: (home, irrigation, municipal, industrial)	white clay	100	150
WELL COMPLETION DATA: (1) diameter (inches) <u>2"</u>	Blue clay	150	200
(2) total depth (feet) <u>545'</u>	Med Blue sand	200	240
(3) static water level (feet) <u>12'</u> below above top of ground.	Blue clay	240	390
(4) casing <u>9440</u> <u>525'</u> (material) (depth)	Fine Blue sand	390	410
_____ If telescope see back. (size)	Blue clay	410	500
(5) screen <u>20'</u> <u>525'</u> (length) (depth to top)	Coarse Clay sand	500	545
<u>2"</u> <u>SS</u> (size) (material)			
(6) pump _____ (HP) (yield gpm)			
_____ (type power)			
(7) electric log _____ (yes or no)			
_____ (organization running log)			
(8) how well bottom plugged _____ <u>B.W. Moore</u>			
DRILLERS REMARKS: _____			


CODED

OCT 26 1973

WIS. 100  
CEN

If well telescopes please sketch and show depths.

GROUND LEVEL

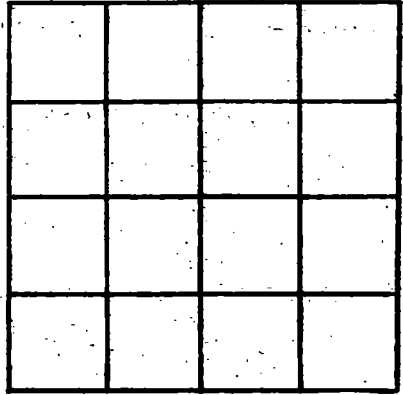

SECTION \_\_\_\_\_

Please indicate well location X.

ADDITIONAL INFORMATION

A series of horizontal lines providing space for additional information.

If more than one screen, show locations of each on sketch.