

Shallow well
HARRISON
N100
3-23-73

MISSISSIPPI
 BOARD OF WATER COMMISSIONERS
 416 North State Street
 Jackson, Mississippi 39201

WATER WELL DRILLERS LOG

March 23 19 *73* *McGill well works* *Harrison*
 date well completed firm name county well located

LANDOWNER: *James Shows*
552 East 2nd.
Ass Christina Mc.
 (mailing address)

description of formations encountered	from	to
<i>Clay</i>	<i>0</i>	<i>44</i>
<i>Coarse Sand</i>	<i>44</i>	<i>60</i>


WELL LOCATION:
 sec *28* T *8* N R *13* E
 S *W*
1 1/2 miles *E* of *Ass Christina*
 (distance) (direction) (nearest town)

WELL PURPOSE: *Municipal*
 (home, irrigation, municipal, industrial)

- WELL COMPLETION DATA:
- (1) diameter (inches) *2"*
 - (2) total depth (feet) *60'*
 - (3) static water level (feet) *6'* below above top of ground.
 - (4) casing *plastic*, *50'*
(material) (depth)
2"
(size) If telescope see back.
 - (5) screen *10'*, *plastic*
(length) (depth to top)
2", *plastic*
(size) (material)
 - (6) pump *1/2* - *9*
(HP) (yield gpm)
electric
(type power)
 - (7) electric log *no*
(yes or no)
 - (8) how well bottom plugged *plug*

CODED

CODED

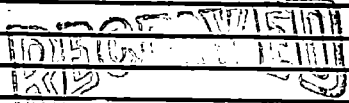

FEB 4 1974

DRILLERS REMARKS:

MISS. BD. OF WATER COMMISSIONERS

If well telescopes please sketch and show depths.

GROUND LEVEL

			X

SECTION 28

Please indicate well location X.

ADDITIONAL INFORMATION

If more than one screen, show locations of each on sketch.