

HARRISON
 N105
 8174

MISSISSIPPI
 BOARD OF WATER COMMISSIONERS
 416 North State Street
 Jackson, Mississippi 39201 CODED

WATER WELL DRILLERS LOG

AUG. 19 74 GRINER DRILLING SERVICE HARRISON
 date well completed firm name county well located


LANDOWNER: <u>E.I. DUPONT</u>	description of formations encountered	from	to
<u>DENEMOURS & Co., OBSERVATION</u>	<u>Top Soil</u>	<u>0</u>	<u>3</u>
<u>WELL NO. 2</u>	<u>Clay</u>	<u>3</u>	<u>12</u>
(mailing address)	<u>SAND, COARSE</u>	<u>12</u>	<u>148</u>
<u>WELL LOCATION:</u>	<u>CLAY</u>	<u>148</u>	<u>242</u>
sec <u>5</u> T <u>8</u> N R <u>13</u> E	<u>SAND</u>	<u>242</u>	<u>628</u>
<u>825' + - S + 625' + - W of NE 1/4</u>	<u>Clay</u>	<u>628</u>	<u>638</u>
(distance) miles (direction) of (nearest town)	<u>SAND, COARSE</u>	<u>638</u>	<u>932</u>
<u>WELL PURPOSE: OBSERVATION</u>	<u>Clay, with thin SANDstone</u>	<u>932</u>	<u>1479</u>
(home, irrigation, municipal, industrial)	<u>SAND, FINE</u>	<u>1473</u>	<u>1553</u>
<u>WELL COMPLETION DATA:</u>	<u>Clay</u>	<u>1553</u>	<u>1571</u>
(1) diameter (inches) <u>6 5/8"</u>	<u>SAND</u>	<u>1571</u>	<u>1636</u>
(2) total depth (feet) <u>1635'</u>			
(3) static water level (feet) <u>71.6</u> <u>below</u> <u>above</u> top of ground.			
(4) casing <u>B.I.</u> <u>1595'</u> (material) (depth)			
<u>6 5/8"</u> (size) if telescope see back.			
(5) screen <u>40'</u> <u>1595'</u> (length) (depth to top)			
<u>4"</u> <u>304 S.S.</u> (size) (material)			
(6) pump <u>NO.</u> <u>600</u> <u>NO. ?</u> (HP) (yield gpm)			
<u>NO.</u> (type power)			
(7) electric log <u>NO.</u> (yes or no)			
(organization running log)			
(8) how well bottom plugged <u>BACK</u> <u>WASH VALVE</u>			
DRILLERS REMARKS: <u>Well 500</u> <u>ft SW of water well no.</u> <u>1</u>			

RECEIVED
 SEP 13 1974

MISS. BD. OF WATER COMMISSIONERS

If well telescopes please sketch and show depths.

GROUND LEVEL

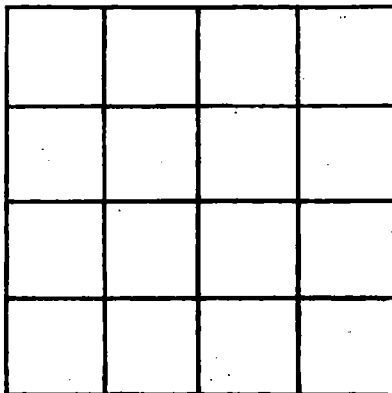

SECTION _____

Please indicate well location X.

ADDITIONAL INFORMATION

If more than one screen, show locations of each on sketch.