

Harrison  
N 110  
7/30/74

MISSISSIPPI  
 BOARD OF WATER COMMISSIONERS CODED  
 416 North State Street  
 Jackson, Mississippi 39201

WATER WELL DRILLERS LOG

Harrison  
 county well located

7/30  
 date well completed

1974 Grinnell Waterworks  
 firm name

LANDOWNER: George Bulin  
Wenderson Point  
Miss  
 (mailing address)

description of formations encountered	from	to
<u>Sandy black soil</u>	<u>0</u>	<u>30'</u>

WELL LOCATION:

sec 38 T 8 N R 13 E 135  
0 miles Center of Harrison  
 (distance) (direction) (nearest town)

<u>white clay</u>	<u>30</u>	<u>110</u>
<u>blue clay</u>	<u>110</u>	<u>230</u>

WELL PURPOSE: Home  
 (home, irrigation, municipal, industrial)

<u>Coarse sand &amp; blue</u>		
<u>pea gravel</u>	<u>230</u>	<u>253</u>

WELL COMPLETION DATA:

- (1) diameter (inches) 2"
- (2) total depth (feet) 253
- (3) static water level (feet) 1 1/2 below top of ground
- (4) casing PVC 243  
 (material) (depth)  
2 if telescope see back.  
 (size)
- (5) screen 10 243  
 (length) (depth to top)  
2 PVC down  
 (size) (material)
- (6) pump 1/2 10  
 (HP) (field gpm)  
E  
 (type power)
- (7) electric log yes  
 (yes or no)  
Stamp  
 (organization running log)
- (8) how well bottom plugged hard  
Stamp


RECEIVED  
 JUN 19 1975

DRILLERS REMARKS:

MISS. BD. OF WATER COMM.

If well telescopes please sketch and show depths.

GROUND LEVEL

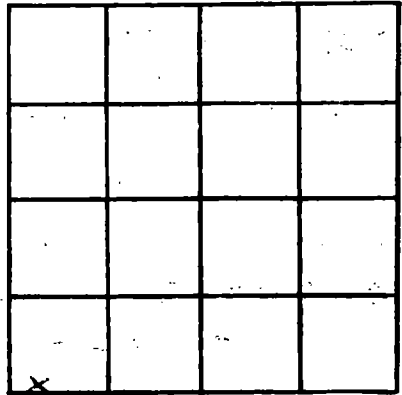

SECTION 35

Please indicate well location X.

ADDITIONAL INFORMATION

If more than one screen, show locations of each on sketch.