

Harrison  
 N 111  
 4/24/74

MISSISSIPPI  
 BOARD OF WATER COMMISSIONERS CODED  
 416 North State Street  
 Jackson, Mississippi 39201

WATER WELL DRILLERS LOG

4/24/74 1974 *Grinnell Water Works* Harrison  
 (date well completed) (firm name) (county well located)

LANDOWNER: *J. C. Yeager*  
*Delite*

*Miss* (mailing address)

WELL LOCATION:  
 0<sup>th</sup> sec. 10 T. 8 N. R. 13 E. 13S  
 0 miles South of Delite  
 (distance) (direction) (nearest town)

WELL PURPOSE: *Home*  
 (home, irrigation, municipal, industrial)

- WELL COMPLETION DATA:
- (1) diameter (inches) 2"
  - (2) total depth (feet) 530
  - (3) static water level (feet) 22" below above top of ground.
  - (4) casing PVC (material), 515 (depth), 2" (size) if telescope see back.
  - (5) screen 15 (length), 515 (depth to top), 2 (size) Johnson Plate (material)
  - (6) pump 1/2 (HP), 10 to 12 (yield gpm), Electric (type power)
  - (7) electric log yes (yes or no), none (organization running log)
  - (8) how well bottom plugged 2" sand

description of formations encountered	from	to
<i>red top clay</i>	<i>0</i>	<i>30'</i>
<i>red sand &amp; gravel</i>	<i>30</i>	<i>100'</i>
<i>white pipe clay</i>	<i>100</i>	<i>230</i>
<i>hard blue pipe clay</i>	<i>230</i>	<i>480</i>
<i>water sand &amp; blue fine gravel</i>	<i>480</i>	<i>530'</i>

*well 2 ft above ground stand 20 ft section 2" pipe pipe 2 ft below on top of well*

*Water come out of top of pipe approx 1 ft to 2" above pipe*


*there to log you taken for me*

DRILLERS REMARKS:

**DE**  
 APR 19 1974  
 MISSISSIPPI BOARD OF WATER COMMISSIONERS

If well telescopes please sketch and show depths.

GROUND LEVEL

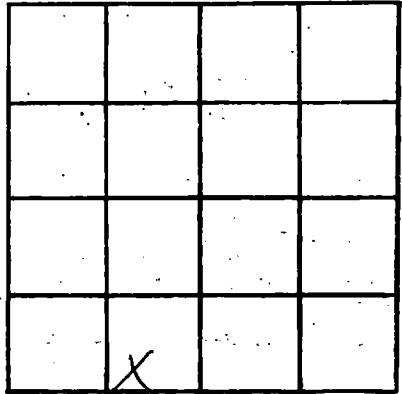

SECTION 10

Please indicate well location X.

ADDITIONAL INFORMATION

If more than one screen, show locations of each on sketch.