

Harrison  
 N 112  
 4-22-74

MISSISSIPPI  
 BOARD OF WATER COMMISSIONERS CODED  
 416 North State Street  
 Jackson, Mississippi 39201

WATER WELL DRILLERS LOG

4/22 1974 *fine will water wells* Harrison  
 date well completed firm name county well located


LANDOWNER: <i>Jae Jeffrey</i> <i>Delisle Miss</i>	description of formations encountered	from	to
<i>home addy S.B. Miss</i> (mailing address)			
WELL LOCATION: sec. <u>10</u> T. <u>8</u> S. R. <u>13</u> E. <sup>135</sup> <u>0</u> miles <u>South</u> of <u>Delisle</u> (distance) (direction) (nearest town)	<i>red top clay</i>	<i>0</i>	<i>30'</i>
WELL PURPOSE: <i>home</i> (home, irrigation, municipal, industrial)	<i>red sand &amp; gravel</i>	<i>30</i>	<i>100</i>
WELL COMPLETION DATA: (1) diameter (inches) <u>2"</u>	<i>white pipe clay</i>	<i>100</i>	<i>230</i>
(2) total depth (feet) <u>532 ft</u>	<i>hard blue pipe clay</i>	<i>230</i>	<i>480</i>
(3) static water level (feet) <u>12</u> <sup>below</sup> above top of ground.	<i>water sand &amp; gravel</i>	<i>480</i>	<i>532'</i>
(4) casing (material) <u>PVC</u> (depth) <u>522</u> <u>2</u> (size) If telescope see back.			
(5) screen (length) <u>10</u> (depth to top) <u>522</u> <u>2"</u> (size) <u>Johnson &amp; Latie</u> (material)			
(6) pump (HP) <u>1/2</u> (yield gpm) <u>10</u> <u>Elc 1</u> (type power)			
(7) electric log (yes or no) <u>yes</u> (organization running log)			
(8) how well bottom plugged <u>2"</u> <u>small chunk</u>			

DRILLERS REMARKS: *I saw  
 you there, took  
 the time you come  
 by to see me  
 but I will then*

RECEIVED  
 JUN 19 1975  
 MISS. BD. OF WATER COMM.

If well telescopes please sketch and show depths.

GROUND LEVEL

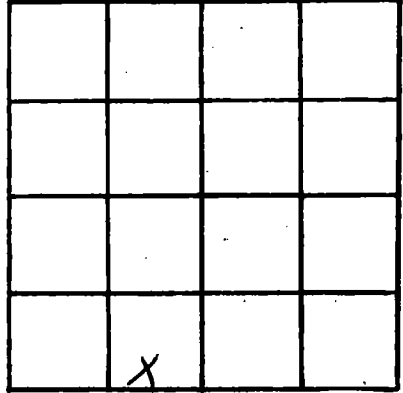

SECTION 10

Please indicate well location X.

ADDITIONAL INFORMATION

If more than one screen, show locations of each on sketch.