

Harrison
 N 203
 4-67

MISSISSIPPI
 BOARD OF WATER COMMISSIONERS
 416 North State Street
 Jackson, Mississippi 39201

CODED

WATER WELL DRILLERS LOG

4-8 1967 Pineville well works Harrison
 date well completed firm name county well located

LANDOWNER: John W. Patliff
 Rt. R, F.W. Box 25
 Pass Christian, Miss
 (mailing address)

WELL LOCATION:
 sec 25 T 8 N R 13 E
 5 miles NE of Pass Christian
 (distance) (direction) (nearest town)


WELL PURPOSE: Home
 (home, irrigation, municipal, industrial)

WELL COMPLETION DATA:

- (1) diameter (inches) 2"
- (2) total depth (feet) 409'
- (3) static water level (feet) 62" below top of ground
- (4) casing gal pipe 399' (material) (depth)
- (5) screen 10ft, 399' (length) (depth to top)
 2" sb. on gal pipe (size) (material)
- (6) pump 1/2 hp (HP) (yield gpm)
 Elec. (type power)
- (7) electric log None (yes or no)
 None (organization running log)
- (8) how well bottom plugged Wash valve w/steels

description of formations encountered	from	to
Red sand & gravel	0	25'
hardy soil	25'	100'
hard blue mud on clay formation	100'	360'
black pepper & sand	360'	409'
gap	409'	409'

CODED

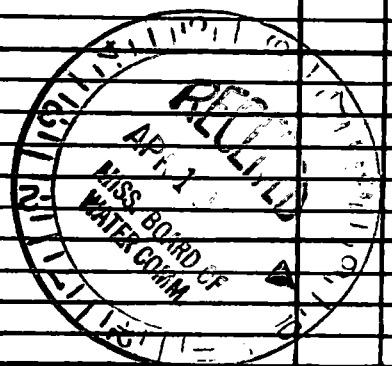

DRILLERS REMARKS:

If well telescopes please
sketch and show depths.

GROUND LEVEL

SECTION _____

Please indicate well location X.

ADDITIONAL INFORMATION

If more than one screen,
show locations of each on sketch.