

Harrison, Co.
 N 204
 8-68

MISSISSIPPI
 BOARD OF WATER COMMISSIONERS
 416 North State Street
 Jackson, Mississippi 39201

CODED

WATER WELL DRILLERS LOG

8-27-1968 date well completed
 Sutter Well Works firm name
 Harrison county well located

LANDOWNER: Ernest Gonzalez
 Henderson Point
 Pass Christian Miss
 (mailing address)

description of formations encountered	from	to
	Clay	0
Sand	10	26
Clay	26	158
Sand	158	173
Clay	173	238
Sand	238	262

WELL LOCATION:
 sec 27 T. 8 N. R. 13 E.
 (S) (W)
 miles W Pass Christian
 (distance) (direction) (nearest town)


WELL PURPOSE:
 (home, irrigation, municipal, industrial)
 home

- WELL COMPLETION DATA:
- (1) diameter (inches) 2
 - (2) total depth (feet) 262
 - (3) static water level (feet) _____ below above
 top of ground.
 - (4) casing galv, 252'
(material) (depth)
2"
(size) if telescope see back.
 - (5) screen 10', 252'
(length) (depth to top)
2", stainless steel
(size) (material)
 - (6) pump 1 15
(HP) (yield gpm)
elec
(type power)
 - (7) electric log no
(yes or no)

CODED

(organization running log)
 (8) how well bottom plugged BPV

DRILLERS REMARKS:

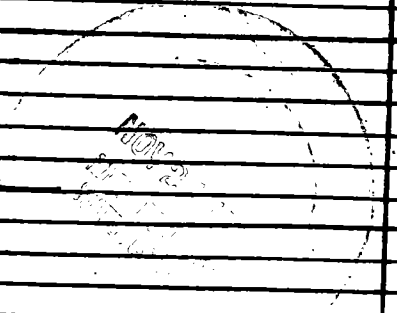

If well telescopes please sketch and show depths.

GROUND LEVEL

SECTION _____

Please indicate well location X.

ADDITIONAL INFORMATION

If more than one screen, show locations of each on sketch.