

Harrison
 N 205
 9-12-68

MISSISSIPPI
 BOARD OF WATER COMMISSIONERS
 416 North State Street
 Jackson, Mississippi 39201

CODED

WATER WELL DRILLERS LOG

9-12-1968 date well completed
 Lutter Well Works firm name
 Harrison county well located

LANDOWNER: Discovery Bay
Gulf Coast Ship. Center
Pass Christian Miss.
 (mailing address)

description of formations encountered	from	to
<u>Sand</u>	<u>0</u>	<u>14</u>
<u>Clay</u>	<u>14</u>	<u>215</u>
<u>sand - soft clay</u>	<u>215</u>	<u>300</u>
<u>Clay</u>	<u>300</u>	<u>498</u>
<u>Sand</u>	<u>498</u>	<u>531</u>


WELL LOCATION:
 sec. 14 T. S N. R. 13 E. W.
 miles N of Pass Christian
 (distance) (direction) (nearest town)

WELL PURPOSE:
 (home, irrigation, municipal, industrial)

CODED

WELL COMPLETION DATA:


- (1) diameter (inches) 1 1/4"
- (2) total depth (feet) 531
- (3) static water level (feet) below above top of ground.
- (4) casing galv. (material), 526' (depth)
1/4 (size) if telescope see back.
- (5) screen 5' (length), 526' (depth to top)
2" (size), stainless steel (material)
- (6) pump none (HP), (yield gpm)
 (type power)
- (7) electric log no (yes or no)
 (organization running log)
- (8) how well bottom plugged BP Value

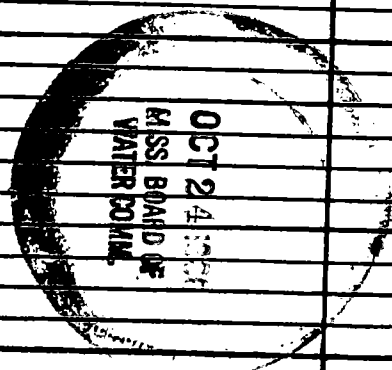

DRILLERS REMARKS:

If well telescopes please sketch and show depths.

GROUND LEVEL

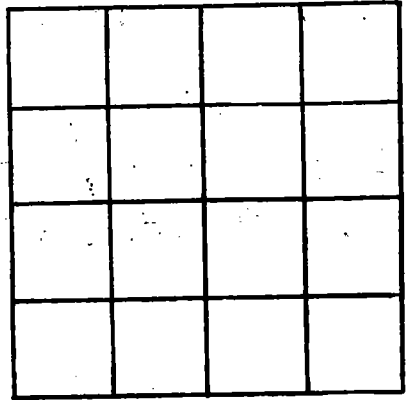

SECTION _____

Please indicate well location X.

ADDITIONAL INFORMATION

If more than one screen, show locations of each on sketch.