

CODED
CODED

MISSISSIPPI
BOARD OF WATER COMMISSIONERS
416 North State Street
Jackson, Mississippi 39201

WATER WELL DRILLERS LOG

Harrison
N 206
10-28-68

date well completed 10-28 1968 firm name Sutter Well Works county well located Harrison

LANDOWNER: W H Smith Sr.

RT 1

Pass Christian Miss
(mailing address)

WELL LOCATION:

sec. 6 T. S N. R 13 E. W
miles WEST (distance) (direction) (nearest town) Helix

WELL PURPOSE: Home
(home, irrigation, municipal, industrial)


WELL COMPLETION DATA:

- (1) diameter (inches) 2
- (2) total depth (feet) 532
- (3) static water level (feet) below top of ground above
- (4) casing Galv. 522'
(material) (depth)
- 2"
(size) if telescope see back.
- (5) screen 10' 522'
(length) (depth to top)
- 2" Stainless Steel
(size) (material)
- (6) pump None unknown
(HP) (yield gpm)
- (type power)
- (7) electric log No
(yes or no)
- (organization running log)
- (8) how well bottom plugged BPU

description of formations encountered	from	to
<u>Clay</u>	<u>0</u>	<u>15</u>
<u>Sand</u>	<u>15</u>	<u>98</u>
<u>Clay</u>	<u>98</u>	<u>300</u>
<u>Sand</u>	<u>300</u>	<u>336</u>
<u>Clay</u>	<u>336</u>	<u>468</u>
<u>Sand</u>	<u>468</u>	<u>532</u>

CODED

Slight flow

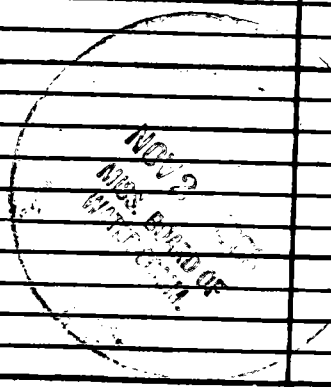

DRILLERS REMARKS:

If well telescopes please sketch and show depths.

GROUND LEVEL

SECTION _____

Please indicate well location X.

ADDITIONAL INFORMATION

If more than one screen, show locations of each on sketch.