

CODED

MISSISSIPPI
 BOARD OF WATER COMMISSIONERS
 416 North State Street
 Jackson, Mississippi 39201

WATER WELL DRILLERS LOG

10-30 1968 Int'l Well Works Harrison
 date well completed firm name county well located

LANDOWNER: Leon Ladner

P.O. 1 Box 103
Pass Christian Miss
 (mailing address)

WELL LOCATION:
 sec. 6 T. S N. 1 R. 11 E. W
 (distance) miles west of Delisle
 (direction) (nearest town)


WELL PURPOSE: home
 (home, irrigation, municipal, industrial)

WELL COMPLETION DATA:

- (1) diameter (inches) 2
- (2) total depth (feet) 645
- (3) static water level (feet) ? ^{below} _{above} top of ground.
- (4) casing galv. 6'30"
 (material) (depth)
2" if telescope see back.
 (size)
- (5) screen 15' 6'30"
 (length) (depth to top)
2" Stainless Steel
 (size) (material)
- (6) pump none
 (HP) (yield gpm)
 (type power)
- (7) electric log no
 (yes or no)
 (organization running log)
- (8) how well bottom plugged B.P. Value

description of formations encountered	depth	
	from	to
Clay	0	8
sand	8	26
Clay	26	39
sand	39	81
Clay	81	284
sand	284	320
Clay	320	471
sand	471	525
Clay	525	585
sand	585	645

CODED

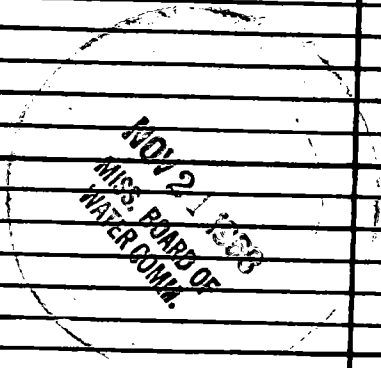

DRILLERS REMARKS:

03000

If well telescopes please sketch and show depths.

GROUND LEVEL

1.0
1.5
2.0
1.0
1.5
2.0
1.0	1.5	2.0	2.5
3.0	3.5	4.0	4.5
5.0	5.5	6.0	6.5
7.0	7.5	8.0	8.5

SECTION

Please indicate well location X.

ADDITIONAL INFORMATION

If more than one screen, show locations of each on sketch.