

CODED

MISSISSIPPI
 BOARD OF WATER COMMISSIONERS
 416 North State Street
 Jackson, Mississippi 39201

WATER WELL DRILLERS LOG

Harrison
N 208
12-11-68

12-11-68 date well completed
 Sutter Well Works firm name
 Harrison county well located

LANDOWNER: John Angell
Pear Christian
Miss
 (mailing address)

WELL LOCATION:
 sec 27 T 4 N R 13 E
1 miles W of Pear Christian
 (distance) (direction) (nearest town)

WELL PURPOSE: home
 (home, irrigation, municipal, industrial)

WELL COMPLETION DATA:

- (1) diameter (inches) 2
- (2) total depth (feet) 257
- (3) static water level (feet) 2 below above top of ground.
- (4) casing galv, 252'
 (material) (depth)
2" If telescope see back.
 (size)
- (5) screen 5', 252'
 (length) (depth to top)
2", stainless steel
 (size) (material)
- (6) pump unknown
 (HP) (yield gpm)
 (type power)
- (7) electric log no
 (yes or no)
 (organization running log)
- (8) how well bottom plugged BPU value

description of formations encountered	from	to
<u>Sand</u>	<u>0</u>	<u>30</u>
<u>Clay</u>	<u>30</u>	<u>150</u>
<u>sand</u>	<u>150</u>	<u>175</u>
<u>Clay</u>	<u>175</u>	<u>237</u>
<u>sand</u>	<u>237</u>	<u>257</u>

CODED


DRILLERS REMARKS:

FEB 19 1969

MISS. BD. OF
 WATER COMMISSIONERS

If well telescopes please sketch and show depths.

GROUND LEVEL

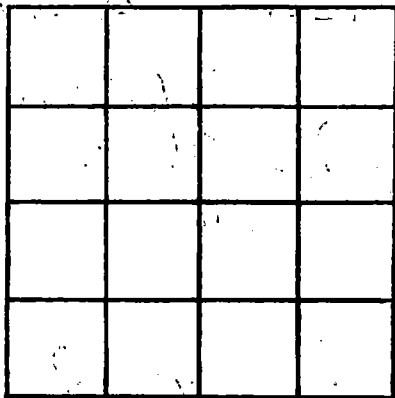

SECTION _____

Please indicate well location X.

ADDITIONAL INFORMATION

If more than one screen, show locations of each on sketch.