

**CODED**

MISSISSIPPI  
BOARD OF WATER COMMISSIONERS  
416 North State Street  
Jackson, Mississippi 39201

**WATER WELL DRILLERS LOG**

Harrison  
N213  
1-22-69

1-22 1969 date well completed     Lutter Wheel Works firm name     Harrison county well located

LANDOWNER: E. J. Cook Jr.  
412 3rd Ave  
Henderson Point Miss  
(mailing address)

WELL LOCATION:  
sec 27 T 8 N R 13 E  
S W  
1 miles W Pass Christian  
(distance) (direction) (nearest town)

WELL PURPOSE: Home  
(home, irrigation, municipal, industrial)

- WELL COMPLETION DATA:
- (1) diameter (inches) 2
  - (2) total depth (feet) 257
  - (3) static water level (feet) 4 below above top of ground.
  - (4) casing Galv, 252'  
(material) (depth)  
2"  
(size) If telescope see back.
  - (5) screen 5', 252'  
(length) (depth to top)  
2", Stainless Steel  
(size) (material)
  - (6) pump 1/3, 10  
(HP) (yield gpm)  
elec  
(type power)
  - (7) electric log no  
(yes or no)
- (organization running log)
- (8) how well bottom plugged BP Valve

description of formations encountered	from	to
Sand	0	26
Clay	26	140
Sand	140	206
Clay	206	237
Sand	237	257

**CODED**


DRILLERS REMARKS:

FEB 13 1969

MISS. BD. OF  
WATER COM.

If well telescopes please sketch and show depths.

GROUND LEVEL

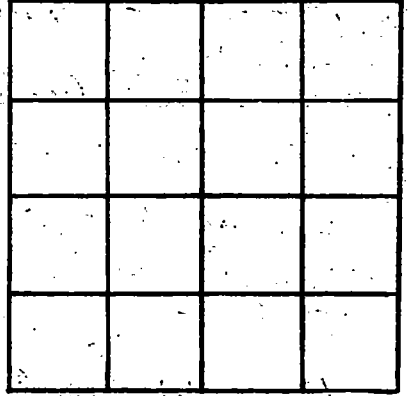

SECTION \_\_\_\_\_

Please indicate well location X.

ADDITIONAL INFORMATION

If more than one screen, show locations of each on sketch.