

HARRISON  
N 217

MISSISSIPPI  
BOARD OF WATER COMMISSIONERS  
416 North State Street  
Jackson, Mississippi 39201

WATER WELL DRILLERS LOG

APRIL 25 1969 MGBILL HARRISON  
date well completed firm name county well located

LANDOWNER: EW WELCH  
2121 31 ST  
GULFPORT  
(mailing address)

description of formations encountered	from to	
	feet	feet
CLAY	0	18
SAND	18	30
CLAY	30	40
SAND	40	60

WELL LOCATION:  
sec. 33 T. 12 S. R. 7 E  
4 miles SW of CUEVAS  
(distance) (direction) (nearest town)

WELL PURPOSE: HOME  
(home, irrigation, municipal, industrial)

WELL COMPLETION DATA:

(1) diameter (inches) 2 1/2

(2) total depth (feet) 60

(3) static water level (feet) \_\_\_\_\_ below above top of ground. FLOW well 40 POWB

(4) casing NONE (material), (depth) \_\_\_\_\_  
(size) If telescope see back.

(5) screen 5' 55 (length), (depth to top)  
2' 55 (size), (material)

(6) pump none (HP) \_\_\_\_\_ (yield gpm)  
none (type power)

(7) electric log NO (yes or no)  
(organization running log)

(8) how well bottom plugged B.W


JUN 30 1969

MISS. BD. OF WATER COM.

DRILLERS REMARKS:

If well telescopes please sketch and show depths.

GROUND LEVEL

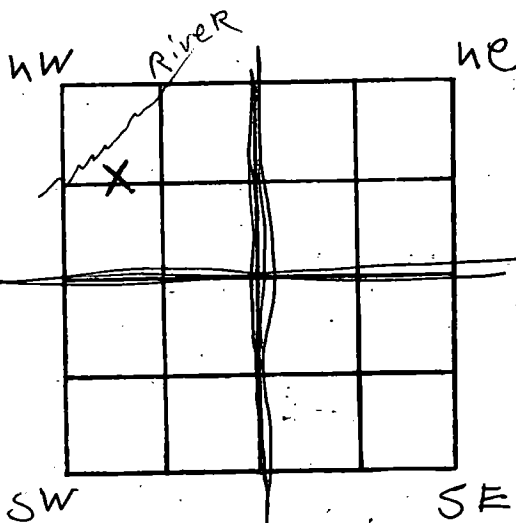

SECTION 33

Please indicate well location X.

ADDITIONAL INFORMATION

If more than one screen, show locations of each on sketch.