

**MISSISSIPPI
BOARD OF WATER COMMISSIONERS**
416 North State Street
Jackson, Mississippi 39201

CODED
CODED

WATER WELL DRILLERS LOG

Harrison
N 220
6-19-69

6-19 1969 Butter Well Works Harrison
date well completed firm name county well located


| LANDOWNER: <u>Timber Ridge & Pass Christian, Miss.</u> (mailing address) | Description of formations encountered | from | to |
|---|---------------------------------------|------------|------------|
| | <u>Clay</u> | <u>0</u> | <u>10</u> |
| | <u>sand</u> | <u>10</u> | <u>19</u> |
| | <u>Clay</u> | <u>19</u> | <u>183</u> |
| | <u>sand</u> | <u>183</u> | <u>226</u> |
| | <u>Clay</u> | <u>226</u> | <u>296</u> |
| | <u>sand</u> | <u>296</u> | <u>327</u> |
| WELL LOCATION: sec. <u>23</u> T <u>2</u> R. <u>13</u> S W | | | |
| <u>1</u> miles <u>N</u> of <u>Pass Christian</u> (distance) (direction) (nearest town) | | | |
| WELL PURPOSE: <u>office Bldg</u> (home, irrigation, municipal, industrial) | | | |
| WELL COMPLETION DATA: # <u>2</u> " | | | |
| (1) diameter (inches) <u>2</u> | | | |
| (2) total depth (feet) <u>327'</u> | | | |
| (3) static water level (feet) <u>2</u> below above top of ground. | | | |
| (4) casing <u>Galv.</u> <u>317'</u> (material) (depth) | | | |
| <u>2"</u> (size) If telescope see back. | | | |
| (5) screen <u>10'</u> <u>317'</u> (length) (depth to top) | | | |
| <u>2"</u> <u>Stainless steel</u> (size) (material) | | | |
| (6) pump <u>1/2</u> <u>10</u> (HP) (yield gpm) | | | |
| <u>elec</u> (type power) | | | |
| (7) electric log <u>no</u> (yes or no) | | | |
| (organization running log) | | | |
| (8) how well bottom plugged <u>BPV value</u> | | | |
| DRILLERS REMARKS: | | | |

JAN 12 1970

MISS. BD. OF
WATER COMM.

If well telescopes please sketch and show depths.

GROUND LEVEL

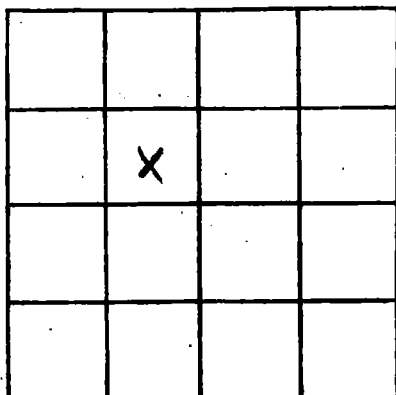

SECTION 23

Please indicate well location X.

ADDITIONAL INFORMATION

If more than one screen, show locations of each on sketch.