

Harrison
 N 225
 10-10-69

MISSISSIPPI
 BOARD OF WATER COMMISSIONERS
 416 North State Street
 Jackson, Mississippi 39201

CODED
 CODED

WATER WELL DRILLERS LOG

10-10 1969 Sutter Well Wks. Harrison
 date well completed firm name county well located


LANDOWNER: <u>Timber Ridge</u>	description of formations encountered	from	to
<u>Pass Christian</u>			
<u>Miss</u>	<u>Clay</u>	<u>0</u>	<u>8</u>
(mailing address)	<u>sand</u>	<u>8</u>	<u>36</u>
WELL LOCATION:	<u>Clay</u>	<u>36</u>	<u>57</u>
sec. <u>26</u> T. <u>8</u> S. R. <u>13</u> E. W. <u>5</u>	<u>sand</u>	<u>57</u>	<u>90</u>
<u>1/2</u> miles <u>N</u> of <u>Pass Christian</u>	<u>Clay</u>	<u>90</u>	<u>194</u>
(distance) (direction) (nearest town)	<u>sand</u>	<u>194</u>	<u>215</u>
WELL PURPOSE: <u>office Bldg</u>			
(home, irrigation, municipal, industrial)			
WELL COMPLETION DATA: <u>#3</u>			
(1) diameter (inches) <u>2"</u>			
(2) total depth (feet) <u>215'</u>			
(3) static water level (feet) <u>7'</u> below top of ground			
(4) casing <u>galv</u> (material), <u>210'</u> (depth)			
<u>2"</u> (size) if telescope see back.			
(5) screen <u>5'</u> (length), <u>210'</u> (depth to top)			
<u>2"</u> (size), <u>Stainless Steel</u> (material)			
(6) pump <u>1</u> (HP), <u>20</u> (yield gpm)			
<u>elec</u> (type power)			
(7) electric log <u>no</u> (yes or no)			
(organization running log)			
(8) how well bottom plugged <u>BPU value</u>			
DRILLERS REMARKS:			

JAN 12 1970

MISS. BD. OF
 WATER COMM.

If well telescopes please sketch and show depths.

GROUND LEVEL

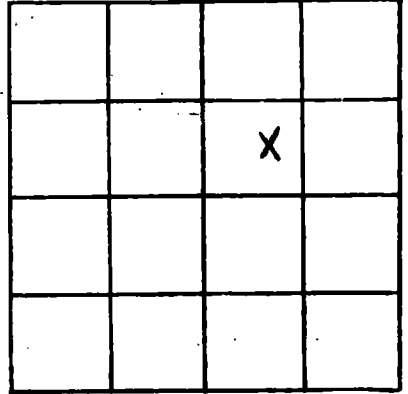

SECTION 26

Please indicate well location X.

ADDITIONAL INFORMATION

If more than one screen, show locations of each on sketch.