

Retained 3/14/69

MISSISSIPPI
BOARD OF WATER COMMISSIONERS
416 North State Street
Jackson, Mississippi 39201

by Charles
2/18/69
2/18/70

WATER WELL DRILLERS LOG

COPIED

Jackson
N 232
9-62

Sept 1962 Lawrence Well Works Corporation
date well completed firm name county well located

LANDOWNER: C. Davis
Bayou Portage Sub
(mailing address)

description of formations encountered from to

WELL LOCATION:
sec. 29 T 8 N R 13 E
miles of (distance) (direction) (nearest town)

unable to supply this information as records lost in Corvallis hurricane etc

WELL PURPOSE:
(home, irrigation, municipal, industrial)

WELL COMPLETION DATA:


- (1) diameter (inches) 2"
- (2) total depth (feet) 226
- (3) static water level (feet) 3 ^{below} top of ground
- (4) casing Galv. 226 (material) (depth)
- (size) if telescope see back.
- (5) screen 40 226 (length) (depth to top)
- 2 slott. Brass (size) (material)
- (6) pump Custom Installed (HP) (yield gpm)
- (type power)
- (7) electric log (yes or no)
- (organization running log)
- (8) how well bottom plugged B.W.W.

Need for records
County of
COPIED
MAR 11 1969
MISS. BD. W.
PRIVATE PROPERTY
CORVALLIS

DRILLERS REMARKS:

If well telescopes please sketch and show depths.

GROUND LEVEL

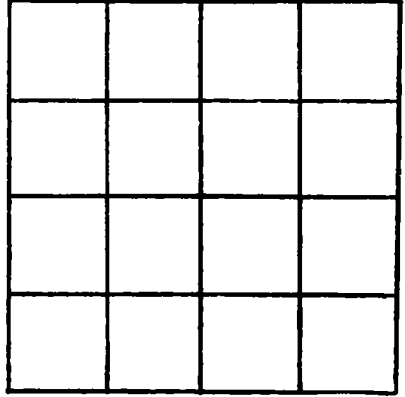

SECTION _____

Please indicate well location X.

ADDITIONAL INFORMATION

If more than one screen, show locations of each on sketch.