

Harrison
 N 237
 4-20-70

MISSISSIPPI
 BOARD OF WATER COMMISSIONERS
 416 North State Street
 Jackson, Mississippi 39201

CODED

WATER WELL DRILLERS LOG

4-20 1970 date well completed SUTTER WELL WORKS firm name Harrison county well located

LANDOWNER: NOEL SELLER

Mc Pile, Miss.

(mailing address)

WELL LOCATION:

sec. 2 T. 8 S. R. 13 W.
 miles IN of Mc Pile
 (distance) (direction) (nearest town)

WELL PURPOSE: 2"
 (home, irrigation, municipal, industrial)

WELL COMPLETION DATA:

- (1) diameter (inches) 2"
- (2) total depth (feet) 236'
- (3) static water level (feet) 5' below
 top of ground above
- (4) casing galv, 216'
 (material) (depth)
2" If telescope see back.
 (size)
- (5) screen 10', 216'
 (length) (depth to top)
2", Stainless Steel
 (size) (material)
- (6) pump 1/3, 10
 (HP) (yield gpm)
elec
 (type power)
- (7) electric log no
 (yes or no)

(organization running log)

(8) how well bottom plugged B.P. Value

description of formations encountered

from to

Clay	0	15
Sand	15	78
Clay	78	180
Sand	180	236


DRILLERS REMARKS:

MAY 4 1970

MISS. BD. OF
 WATER COMM.

If well telescopes please sketch and show depths.

GROUND LEVEL

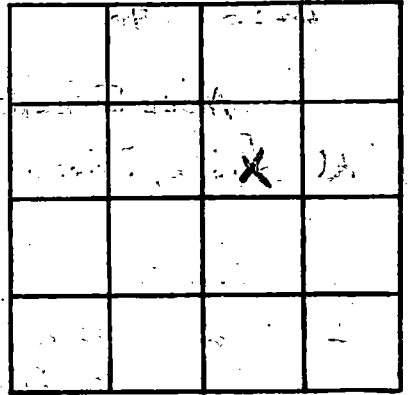

SECTION 2

Please indicate well location X.

ADDITIONAL INFORMATION

If more than one screen,
show locations of each on sketch.