

HARRISON
 N 238
 8-4-70

MISSISSIPPI
 BOARD OF WATER COMMISSIONERS
 416 North State Street
 Jackson, Mississippi 39201

CODED

WATER WELL DRILLERS LOG

SUTTER WELL WORKS

Harrison
 county well located

Aug. 4 1970
 date well completed

firm name

LANDOWNER: Sweet Bay
 Condominium
 Pass Christian,
 Miss.
 (mailing address)

WELL LOCATION:
 sec. 22 T. 8 S R. 13 W 024
 1 miles N of Pass Christian
 (distance) (direction) (nearest town)

description of formations encountered	from	to
Clay	0	15
Sand	15	31
Clay	31	148
Sand	148	240
Clay	240	273
Sand	273	325

WELL PURPOSE: Apt. house
 (home, irrigation, municipal, industrial)

- WELL COMPLETION DATA:
- (1) diameter (inches) 2"
 - (2) total depth (feet) 325'
 - (3) static water level (feet) 1/2' ~~xxxx~~ above top of ground.
 - (4) casing galv. 315'
 (material) (depth)
 2" if telescope see back.
 (size)
 - (5) screen 10' 315'
 (length) (depth to top)
 2" stainless steel
 (size) (material)
 - (6) pump 1 15
 (HP) (yield gpm)
 elec.
 (type power)
 - (7) electric log no
 (yes or no)
 (organization running log)
 - (8) how well bottom plugged B.P. Valve

CODED


AUG 31 1970

DRILLERS REMARKS:

MISS. BD. OF
 WATER COMM.

If well telescopes please sketch and show depths.

GROUND LEVEL

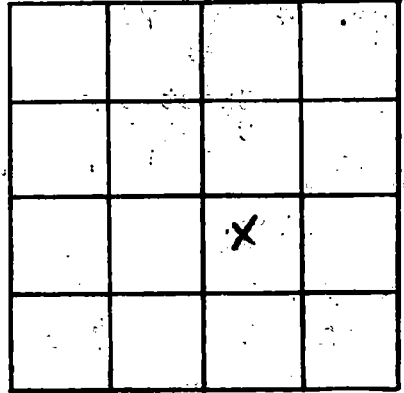

SECTION 22

Please indicate well location X.

ADDITIONAL INFORMATION

If more than one screen, show locations of each on sketch.