

HARRISON

N 239

8-26-70

MISSISSIPPI BOARD OF WATER COMMISSIONERS 416 North State Street Jackson, Mississippi 39201

CODED

WATER WELL DRILLERS LOG

8-26

1970 Patton Well Serv Harrison

date well completed

firm name

county well located

LANDOWNER: R.S. Ladner

description of formations encountered

from to

DeLisle Miss (mailing address)

Surface Clay	0	36
Sand + Gravel	36	105
yellow clay	105	125
Blue clay	125	190
Sand	190	255
Blue clay	255	455
Sand	455	480
Blue clay	480	490
Grey sand	490	549

WELL LOCATION:

sec 58 T 8 N R 13 W S W

0 miles Center of DeLisle (distance) (direction) (nearest town)

WELL PURPOSE: Home (home, irrigation, municipal, industrial)

WELL COMPLETION DATA:

- (1) diameter (inches) 2
- (2) total depth (feet) 549
- (3) static water level (feet) flow below above top of ground.
- (4) casing (material) Galv. (depth) 529
- (size) 2 If telescope see back.
- (5) screen (length) 10' (depth to top) 529
- (size) 2 (material) S. Steel
- (6) pump (HP) (yield gpm)
- (type power)
- (7) electric log NO (yes or no)
- (organization running log)
- (8) how well bottom plugged Builvalve

CODED


DRILLERS REMARKS: + 8'

SEP 15 1970

MISS. BD. OF WATER COMM.

If well telescopes please sketch and show depths.

GROUND LEVEL

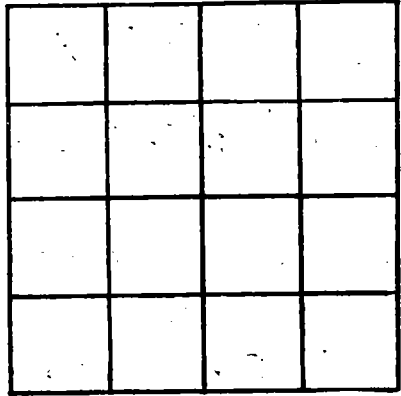

SECTION 8

Please indicate well location X.

ADDITIONAL INFORMATION

If more than one screen, show locations of each on sketch.