

HARRISON
 NO 241
 9-1-70

MISSISSIPPI
 BOARD OF WATER COMMISSIONERS
 416 North State Street
 Jackson, Mississippi 39201

CODED

WATER WELL DRILLERS LOG

9-1-70 19 Sutter Well Works Harrison
 date well completed firm name county well located

LANDOWNER: Chas. Clark
De Lisle, Miss.

description of formations encountered

from to

Clay	0	18
Sand	18	65
Clay	65	218
Sand	218	236

(mailing address)

WELL LOCATION:

sec. 3 T. 8 S. R. 13 W.
1 miles NE of DeLisle
 (distance) (direction) (nearest town)

WELL PURPOSE: home
 (home, irrigation, municipal, industrial)

WELL COMPLETION DATA:

- (1) diameter (inches) 2"
- (2) total depth (feet) 236'
- (3) static water level (feet) 7' below top of ground.
- (4) casing galv. 231'
 (material) (depth)
2" If telescope see back.
 (size)
- (5) screen 5' 231'
 (length) (depth to top)
2" stainless steel
 (size) (material)
- (6) pump unknown
 (HP) (yield gpm)
 (type power)
- (7) electric log no
 (yes or no)
 (organization running log)
- (8) how well bottom plugged B.P. Valve


CODED

OCT 19 1970
 MISS. Bd. OF WATER COMMISSIONERS

DRILLERS REMARKS:

If well telescopes please sketch and show depths.

GROUND LEVEL

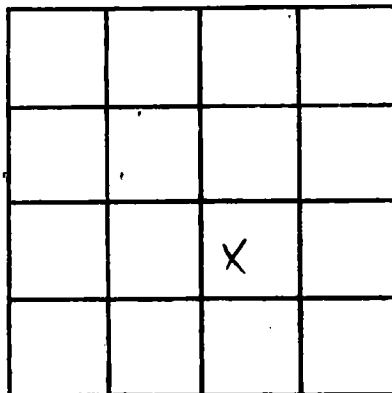

SECTION 3

Please indicate well location X.

ADDITIONAL INFORMATION

If more than one screen, show locations of each on sketch.