

HAR.

MISSISSIPPI BOARD OF WATER COMMISSIONERS

N247
7-28-60

Q 462 508

WATER WELL DRILLERS LOG

CODED

Date: 7-18, 1960, Driller: Leroy Beed County Harrison
(Name)

(1) Owner of Land: Terry Saucier
(Name)
RT-1 Paul Christian
(Address)
37 7 13
(2) Location: 1/4, 1/4, Sec. T R
2 miles East, of Delisle
(distance) (direction) (Nearest Town)
(3) Topography: X
(Hilly) (Flat) (Level)
(4) Purpose of Well: Home use
(Domestic Irrigation
Municipal, Industrial, Other)

Description & Color of Materials Sand, Clay, Red Clay, Shell, etc.	Thick- ness Feet	Depth Feet
<u>Red clay + white sand</u>	<u>126</u>	
<u>Blue clay</u>	<u>90</u>	
<u>Stratton</u>	<u>30</u>	
<u>total depth</u>	<u>246</u>	

CODED


Information upon completion of well:

(1) Diameter 2" X 1/4" inches.
(2) Total Depth 246 feet.
(3) Water Level small flow feet below top of ground.
(4) Cased to _____, Size _____
(5) Screen: Size 1/4", Length 15ft.
(6) Were any formations sealed against pollution?
yes, _____ no.

If YES depth of formation Back filled with sand

Why _____

Drillers Remarks: _____

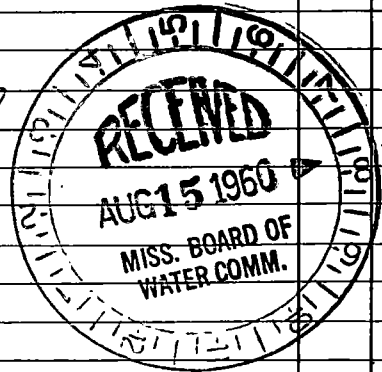

(Use Back Side)

Well No.

