

HAR.

MISSISSIPPI BOARD OF WATER COMMISSIONERS

N248

WATER WELL DRILLERS LOG

CODED

8-23-60

Date: 8-23, 1960, Driller: Butter Well Wks County Harrison

(Name)

(1) Owner of Land: JULES SELLIER
(Name)

He Lisle Drive
(Address)

(2) Location: 7 8 13 T R
IN He Lisle
(distance) (direction) (Nearest Town)

(3) Topography: Flat
(Hilly) (Flat) (Level)

(4) Purpose of Well: domestic
(Domestic Irrigation
Municipal, Industrial, Other)

Description & Color of Materials
Sand, Clay, Red Clay, Shell, etc.

Thick-
ness
Feet

Depth
Feet

Clay

10

10

Sand streaks

58

68

Clay

186

184

Sand

76

260

Clay

248

508

Sand

54

562

CODED

Information upon completion of well:

(1) Diameter 2 inches.

(2) Total Depth 562 feet.

(3) Water Level 20 feet ABOVE ~~below~~ top of ground.

(4) Cased or all, Size 2"

(5) Screen: Size 2", Length 16'


(6) Were any formations sealed against pollution?

yes, no.

If YES depth of formation _____

Why _____

Drillers Remarks: _____

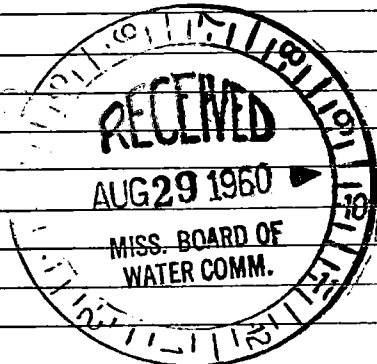

(Use Back Side)

Well N

