

HAR.

CODED

N251

WATER WELL DRILLERS LOG

11-24-60

Date: 11-24, 1960, Driller: J Beed County Hancock

(Name)

(1) Owner of Land: Melvin Sadwa

(Name)

Rt 1 Par Christians

(Address)

(2) Location: 2 8/13

Next Home south white
Cypress miles Catholic Church
(distance) (direction) (Nearest Town)

(3) Topography: Y

(Hilly)

(Flat)

(Level)

(4) Purpose of Well: Home

(Domestic Irrigation
Municipal, Industrial, Other)

Description & Color of Materials Sand, Clay, Red Clay, Shell, etc.	Thick- ness Feet	Depth Feet
<u>Red clay to</u>		<u>63'</u>
<u>White "</u>	<u>1</u>	<u>20</u>
<u>Blue hard clay</u>	<u>2</u>	<u>08</u>
<u>Atracta</u>		<u>25'</u>
<u>Total</u>	<u>2</u>	<u>53</u>

Information upon completion of well:

(1) Diameter 2 1/4 inches.

(2) Total Depth 253 feet.

(3) Water Level 70 feet below top of ground.

(4) Cased to _____, Size _____

(5) Screen: Size 1 1/2" , Length 10ft



(6) Were any formations sealed against pollution?
_____ yes, _____ no.

If YES depth of formation _____

Why _____

Drillers Remarks: _____

CODED

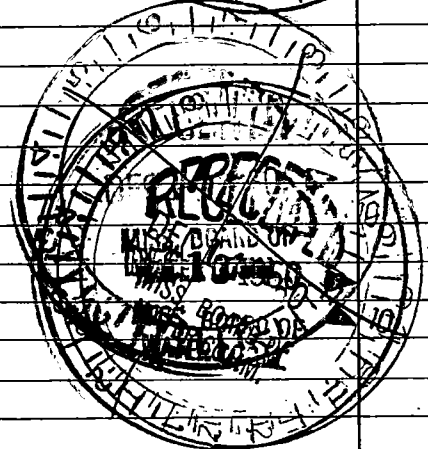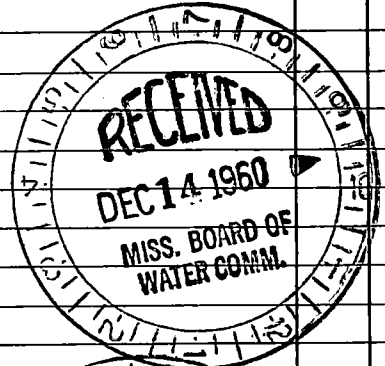

Well No.

(Use Back Side)

