

HAR.  
N252  
1-18-61

MISSISSIPPI BOARD OF WATER COMMISSIONERS

WATER WELL DRILLERS LOG

**CODED**

Date: 1-18, 1961, Driller: J. Beers County Harrison

(Name)

(1) Owner of Land: Clifton Sadrel  
(Name)

Rt 1 Pan Christian  
(Address)

(2) Location: 6 7 13  
T R

2 miles North of Stirling  
(distance) (direction) (Nearest Town)

(3) Topography: X (Hilly) (Flat) (Level)

(4) Purpose of Well: Home  
(Domestic Irrigation  
Municipal, Industrial, Other)

Description & Color of Materials Sand, Clay, Red Clay, Shell, etc.	Thick- ness Feet	Depth Feet
<u>5 ft Red Clay</u>		<u>5</u>
<u>50 ft soft Mud</u>		<u>55</u>
<u>30 ft fine Blue sand</u>		<u>85</u>
<u>49 ft Hard Clay</u>		<u>133</u>
<u>49 ft water sand</u>		<u>182</u>
<u>Total Dept</u>		<u>187</u>

Information upon completion of well:

(1) Diameter 2 1/4 inches.

(2) Total Depth 187 feet.

(3) Water Level 40 feet below top of ground.

(4) Cased to \_\_\_\_\_, Size \_\_\_\_\_

(5) Screen: Size \_\_\_\_\_, Length \_\_\_\_\_


(6) Were any formations sealed against pollution?  
\_\_\_\_\_ yes, \_\_\_\_\_ no.

If YES depth of formation \_\_\_\_\_

Why \_\_\_\_\_

Drillers Remarks: \_\_\_\_\_

**CODED**

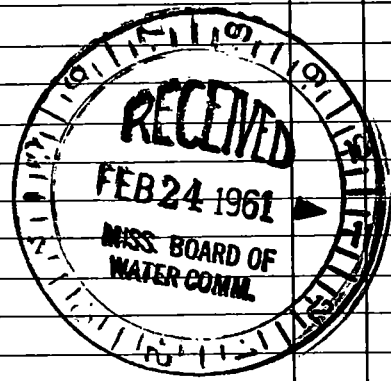

(Use Back Side)

Well No.

1940

100  
100

