

HAR.

MISSISSIPPI BOARD OF WATER COMMISSIONERS

N253

4-14-61

WATER WELL DRILLERS LOG

CODED

Date: 4-14, 1961, Driller: Sutter Well Works County Harrison

(Name)

(1) Owner of Land: C.F. BURKITT (Name)

de Lisle Miss. (Address)

(2) Location: 4 8 / 3 1/4, 1/4, Sec. 8 T R

miles in de Lisle (distance) (direction) (Nearest Town)

(3) Topography: flat (Hilly) (Flat) (Level)

(4) Purpose of Well: domestic (Domestic Irrigation Municipal, Industrial, Other)

Description & Color of Materials Sand, Clay, Red Clay, Shell, etc.	Thick- ness Feet	Depth Feet
Red clay	15	15
sand & gravel	125	140
soft clay & some sand	160	300
clay	145	445
sand	40	485
clay	18	503
sand	47	550
clay	6	556
fine sand	7	563

Information upon completion of well:

(1) Diameter 2 inches.

(2) Total Depth 563 feet.

(3) Water Level 25 feet above below top of ground.

(4) Cased to all, Size 2"

(5) Screen: Size 2", Length 15'

(6) Were any formations sealed against pollution?

yes, no.


If YES depth of formation

Why

Drillers Remarks:

CODED

Strainer set at 550 feet. Blank pipe below strainer to 563'

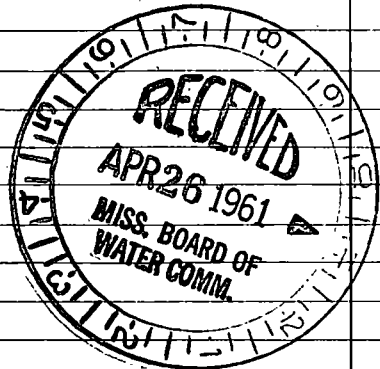

(Use Back Side)

Well No.

