

N 254  
3-1-61

WATER WELL DRILLERS LOG

**CODED**

Date: 3/1, 1961, Driller: Sutter Well Works County Harrison  
(Name)

(1) Owner of Land: Presel Mitchell  
(Name)  
Rt. 1 Pass Christian Miss.  
(Address)

(2) Location: 1/4, 13 Sec. 8 T3R  
3 miles N, of P.C.  
(distance) (direction) (Nearest Town)

(3) Topography: flat  
(Hilly) (Flat) (Level)

(4) Purpose of Well: domestic  
(Domestic Irrigation  
Municipal, Industrial, Other)

Description & Color of Materials Sand, Clay, Red Clay, Shell, etc.	Thick- ness Feet	Depth Feet
<u>Sand</u>	<u>30</u>	<u>30</u>
<u>Clay - Sand streaks</u>	<u>335</u>	<u>365</u>
<u>Sand</u>	<u>40</u>	<u>405</u>

**CODED**


Information upon completion of well:

- (1) Diameter 2 x 1 1/2 inches.
- (2) Total Depth 405 feet.
- (3) Water Level — feet below top of ground.
- (4) Cased to all, Size top 42'-2",  
Balance 1 1/2"
- (5) Screen: Size 1 1/2", Length 5'
- (6) Were any formations sealed against pollution?  
— yes,  no.

If YES depth of formation \_\_\_\_\_

Why \_\_\_\_\_

Drillers Remarks: \_\_\_\_\_

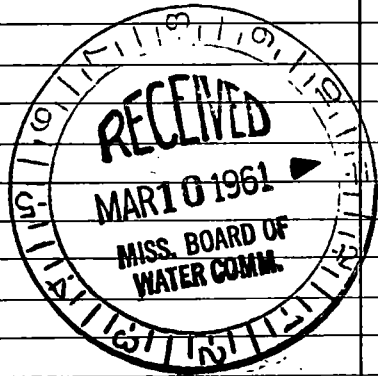

(Use Back Side)

Well No.

