

HAR.

MISSISSIPPI BOARD OF WATER COMMISSIONERS

**CODED**

N2-58  
8-18-61

WATER WELL DRILLERS LOG

Date: 8-18, 1961, Driller: Sutter Well Works County Harrison  
(Name)

- (1) Owner of Land: A J Melon  
(Name)  
Rt. 1 Pass Christian  
(Address)
- (2) Location: 1/4, 22813, Sec. 8 T 13 R  
1 miles N of P.C.  
(distance) (direction) (Nearest Town)
- (3) Topography: flat  
(Hilly) (Flat) (Level)
- (4) Purpose of Well: domestic  
(Domestic Irrigation  
Municipal, Industrial, Other)

Description & Color of Materials Sand, Clay, Red Clay, Shell, etc.	Thick- ness Feet	Depth Feet
<u>Sand</u>	<u>30</u>	<u>30</u>
<u>Clay</u>	<u>15</u>	<u>45</u>
<u>Sand</u>	<u>10</u>	<u>55</u>
<u>Clay</u>	<u>125</u>	<u>180</u>
<u>Sand</u>	<u>9</u>	<u>189</u>

Information upon completion of well:


- (1) Diameter 1 1/4 inches.
- (2) Total Depth 189 feet.
- (3) Water Level 6" above feet below top of ground.
- (4) Cased to all, Size 1 1/4"
- (5) Screen: Size 1 1/4", Length 5'
- (6) Were any formations sealed against pollution?  
no yes,  no.

If YES depth of formation \_\_\_\_\_

Why \_\_\_\_\_

Drillers Remarks: \_\_\_\_\_

**CODED**

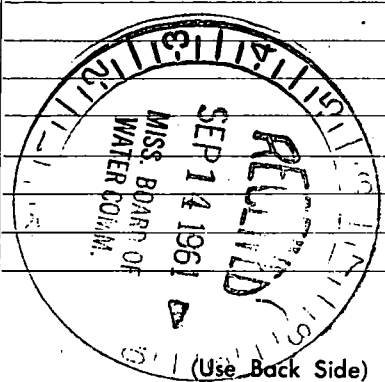

Well No. \_\_\_\_\_

100

Handwritten text at the top of the page, possibly a title or header.

Main body of handwritten text, appearing to be a list or series of entries.

Second section of handwritten text, continuing the list or entries.

Third section of handwritten text, possibly a summary or conclusion.

Final lines of handwritten text at the bottom of the page.