

HAR.

MISSISSIPPI BOARD OF WATER COMMISSIONERS

N 259
9-1-61

WATER WELL DRILLERS LOG

CODED

Date: Sept 1, 1961, Driller C. T. SWITZER WELL CO. County Harrison
(Name)


(1) Owner of Land:	Description & Color of Materials Sand, Clay, Red Clay, Shell, etc.	Thick- ness Feet	Depth Feet
<u>C. V. Fitzgerald</u> (Name) <u>De Lisle, Miss</u> (Address) <u>34? 7 13</u>	<u>clay</u>	<u>8</u>	<u>41</u>
(2) Location: <u>1/4</u> , <u>1/4</u> , Sec. <u>T R</u> , _____ miles _____ of _____ (distance) (direction) (Nearest Town)	<u>sand good red.</u>	<u>41</u>	<u>83</u>
(3) Topography: <u>X</u> (Hilly) (Flat) (Level)	<u>clay</u>	<u>83</u>	<u>115</u>
(4) Purpose of Well: <u>Domestic</u> (Domestic Irrigation Municipal, Industrial, Other)	<u>fine sand</u>	<u>115</u>	<u>140</u>
	<u>clay</u>	<u>140</u>	<u>167</u>
	<u>good sand.</u>	<u>167</u>	<u>188</u>
	<u>clay</u>	<u>194</u>	<u>209</u>
	<u>good sand.</u>	<u>209</u>	<u>259</u>

Information upon completion of well:

- (1) Diameter 2" inches.
- (2) Total Depth 259 feet.
- (3) Water Level 45' feet below top of ground.
- (4) Cased to 259, Size 2"
- (5) Screen: Size 2", Length 10
- (6) Were any formations sealed against pollution?
X yes, _____ no.

If YES depth of formation _____
Why Health Dept Requirement
Drillers Remarks: _____

CODED

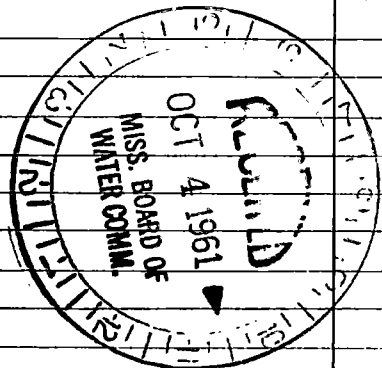

(Use Back Side)

Well No.

100