

N 260

7-31-62 WATER WELL DRILLERS LOG

CODED

Date: 7-31, 1962, Driller: Sutton Well Works County Harrison
 (Name)

(1) Owner of Land: Roger Seligman
 (Name)
Pers Christian
 (Address)
26813

(2) Location: 1/4, 1/4, Sec. 13 T. R
in miles (distance), P.C (direction), (Nearest Town)

(3) Topography: flat
 (Hilly) (Flat) (Level)

(4) Purpose of Well: domestic
 (Domestic Irrigation, Municipal, Industrial, Other)

Description & Color of Materials Sand, Clay, Red Clay, Shell, etc.	Thick- ness Feet	Depth Feet
<u>Sand</u>	<u>30</u>	<u>30</u>
<u>Clay</u>	<u>425</u>	<u>455</u>
<u>Sand</u>	<u>52</u>	<u>507</u>
<u>Clay</u>	<u>2.3</u>	<u>630</u>
<u>Sand</u>	<u>71</u>	<u>701</u>

CODED

Information upon completion of well:

(1) Diameter 4 inches.

(2) Total Depth 701 feet.

(3) Water Level 4 feet above below top of ground.

(4) Cased to all, Size 4"


(5) Screen: Size 4", Length 20'

(6) Were any formations sealed against pollution?
no yes, no.

If YES depth of formation _____

Why _____

Drillers Remarks: _____

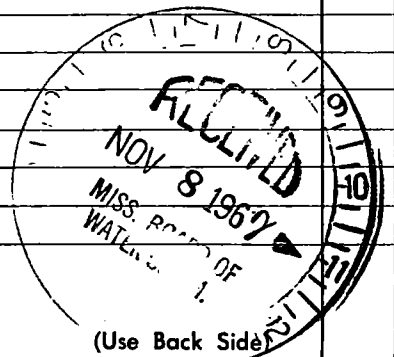

Well No. _____

1911

... ..

...

...

