

HAR.
 N/263-
 7-3-63

WATER WELL DRILLERS LOG

CODED

Date: 7-3, 1963, Driller: Sutter Well Works County Harrison
 (Name)

(1) Owner of Land: S. W. Alexander
 (Name)
Pass Christian
 (Address)
 (2) Location: 1/4, 16 8 12 Sec. T. R.
PC
 (distance) (direction) (Nearest Town)
 (3) Topography: level
 (Hilly) (Flat) (Level)
 (4) Purpose of Well: domestic
 (Domestic Irrigation
 Municipal, Industrial, Other)


Description & Color of Materials Sand, Clay, Red Clay, Shell, etc.	Thick- ness Feet	Depth Feet
Clay	165	165
Sand	13	178
Clay	53	231
Sand	42	273
Clay	121	394
Sand + Clay	26	420
Sand	84	504
Clay	395	899
Sand	101	1000

Information upon completion of well:

(1) Diameter 4 inches.
 (2) Total Depth 1000 feet.
 (3) Water Level 18 feet above below top of ground.
 (4) Cased to all, Size 4"
 (5) Screen: Size 4", Length 20'
 (6) Were any formations sealed against pollution?
 _____ yes, no.

CODED

If YES depth of formation _____
 Why _____
 Drillers Remarks: _____

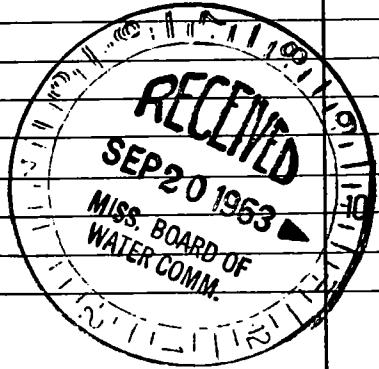

(Use Back Side)

Well No.

