

N 270

4-65

WATER WELL DRILLERS LOG

CODED

Date: Apr, 1965, Driller: Joe Miller County Harrison
 (Name)

(1) Owner of Land: Nolan Cuevas
 (Name)
Pass Christian Miss
 (Address)
 (2) Location: 18 7 13
 1/4, 1/4, Sec. T R
 miles of
 (distance) (direction) (Nearest Town)
 (3) Topography: Hilly
 (Hilly) (Flat) (Level)
 (4) Purpose of Well: Domestic
 (Domestic Irrigation
 Municipal, Industrial, Other)


Description & Color of Materials Sand, Clay, Red Clay, Shell, etc.	Thick- ness Feet	Depth Feet
Surface	5	5
Red Cl + Red Sd	20	25
Wh Sd + Tan Sd.	10	35
Hard Blue Clay	7	42
Grey Sand (Fine)	14	56
Sand + Clay (Sm Br)	34	90
Hard Blue Clay	32	122
" "	66	188
Grey Sand (Fine)	17	205
" " (Fair)	10	215
" " (Good)	11	226
" " "	9	235
Hard Blue Clay	5	240

Information upon completion of well:

(1) Diameter 2" inches.
 (2) Total Depth 310' feet.
 (3) Water Level 22' feet below top of ground.
 (4) Cased to 295', Size 2"
 (5) Screen: Size 2", Length 10'
 (6) Were any formations sealed against pollution?
 _____ yes, _____ no.


If YES depth of formation _____
 Why _____
 Drillers Remarks: _____

CODED

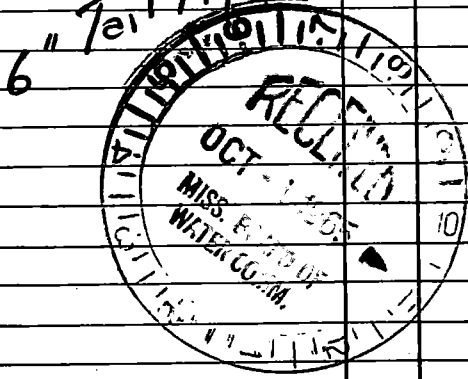

(Use Back Side)

Well No.

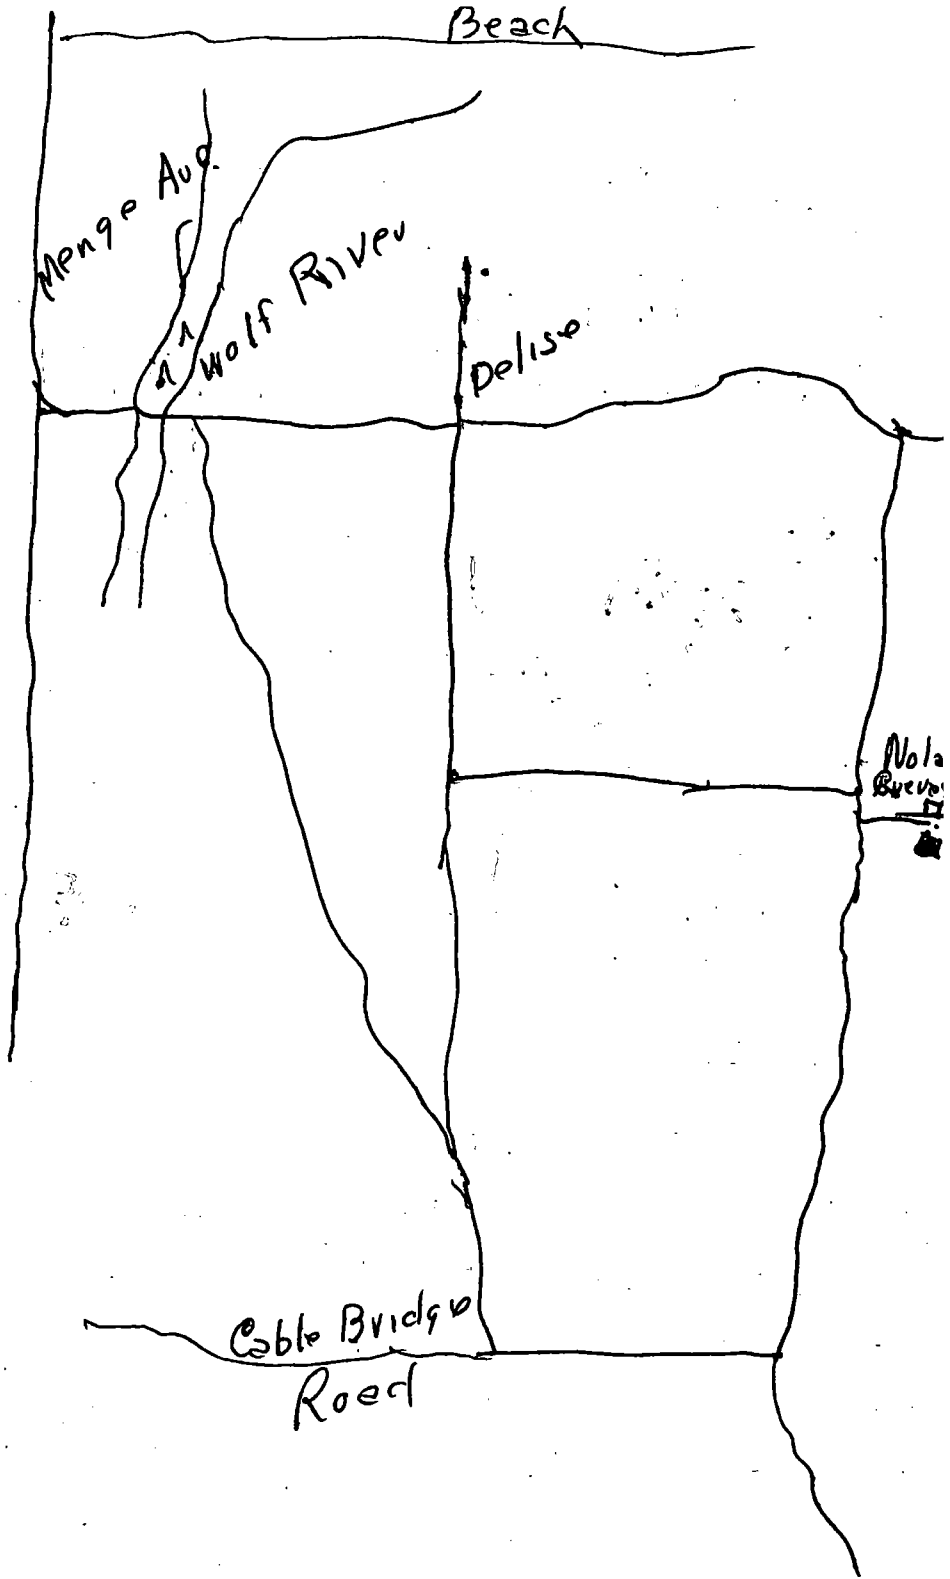

Beach

Menge Ave

Wolf River

Deliso

Nola Bueve

Coble Bridge Road