

HAR.

MISSISSIPPI BOARD OF WATER COMMISSIONERS

N 273

WATER WELL DRILLERS LOG

CODED

11-23-65

Date: 11-23, 1965, Driller: Better Well Works County Harrison

(Name)

(1) Owner of Land: Pass Christian-City (Name)

(Address)

(2) Location: 1/4, 1/4, Sec. T. R.

miles (distance), W, Pass Christian (direction), (Nearest Town)

(3) Topography: flat (Hilly) (Flat) (Level)

(4) Purpose of Well: domestic (Domestic Irrigation, Municipal, Industrial, Other)

Description & Color of Materials Sand, Clay, Red Clay, Shell, etc.

Thick-ness Feet

Depth Feet

Sand	10	10
Soft clay	17	27
Sand	9	36
Clay	26	62
Sand + gravel	8	70

CODED

Information upon completion of well:


- (1) Diameter 2 inches.
- (2) Total Depth 70 feet.
- (3) Water Level 5 feet below top of ground.
- (4) Cased to All, Size 2"
- (5) Screen: Size 2", Length 5'
- (6) Were any formations sealed against pollution?

yes, no.

If YES depth of formation Surface

Why

Drillers Remarks:

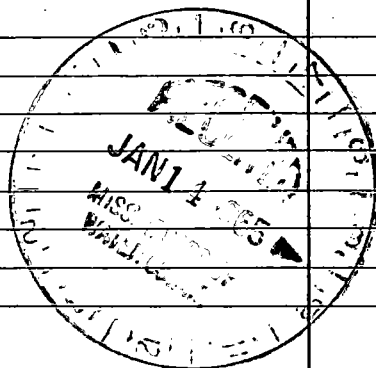

(Use Back Side)

Well No.

