

HAR.

N 275 MISSISSIPPI BOARD OF WATER COMMISSIONERS

5-19-66 WATER WELL DRILLERS LOG

CODED

Date: 5-19, 1966, Driller: Jetter Well Works County Harrison

(When well drilled)

(Name)

(Where well is located)

(1) Owner of Land: Earl Seelien
(Name)
Mc Lisle Drive
(Address)
(2) Location: 7 8 13
1/4, 1/4, Sec. T R
miles in of McLisle
(distance) (direction) (Nearest Town)
(3) Topography: hilly
(Hilly) (Flat) (Level)
(4) Purpose of Well: domestic
(Domestic Irrigation
Municipal, Industrial, Other)


Description & Color of Materials Sand, Clay, Red Clay, Shell, etc.	Thick- ness Feet	Depth Feet
Clay	16	16
sand	64	80
Clay - sand streak	61	141
sand	10	151
Clay	78	229
sand	37	266
Clay	42	308
sand	21	329
Clay - sand streak	172	501
sand	68	569

Information upon completion of well:

(1) Diameter 2 inches.
(2) Total Depth 569 feet.
(3) Water Level 18 feet ^{over} below top of ground.
(4) Cased to all, Size 2"
(5) Screen: Size 2", Length 15'
(6) Were any formations sealed against pollution?
no yes, no.

CODED

If YES depth of formation _____
Why _____
Drillers Remarks: _____
Yield in gpm: 25
Size pump: not furnished
Type power: _____

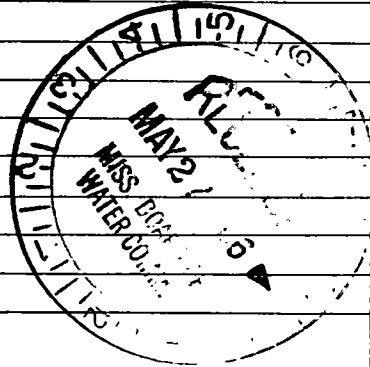



Faint, illegible text and markings covering the upper half of the page.



Extremely faint and illegible text covering the lower half of the page.