

Harrison
 N 279
 3-16-69

MISSISSIPPI
 BOARD OF WATER COMMISSIONERS
 416 North State Street
 Jackson, Mississippi 39201

CODED

WATER WELL DRILLERS LOG

MAR 16 1969 MCGILL HARRISON
 date well completed firm name county well located

LANDOWNER: MOUVE-IR.
 DEDE ARX.
 Rt 1, BOX 111 DEWISLE
 (mailing address)

description of formations encountered	from	to
CLAY	0	40
SAWD	40	60

WELL LOCATION:
 sec. 8 T 8 N R 13 E
 S W
 1/2 miles W of DEWISLE
 (distance) (direction) (nearest town)

WELL PURPOSE: HOME
 (home, irrigation, municipal, industrial)

CODED

WELL COMPLETION DATA:

(1) diameter (inches) 2'

(2) total depth (feet) 60

(3) static water level (feet) 2 below top of ground

(4) casing ~~None~~ (material) (depth) (size) If telescope see back.

(5) screen 5' 55" (length) (depth to top) 2' SS (size) (material)

(6) pump none (HP) (yield gpm) *did not*

(7) electric log none (type power) (yes or no)

(8) how well bottom plugged B.W.


CODED		
<i>James H. Pearl</i>		
JUN 30 1969		
MISS. BD. OF WATER COM. /		

DRILLERS REMARKS:

MISS. BD. OF WATER COM. /

If well telescopes please sketch and show depths.

GROUND LEVEL

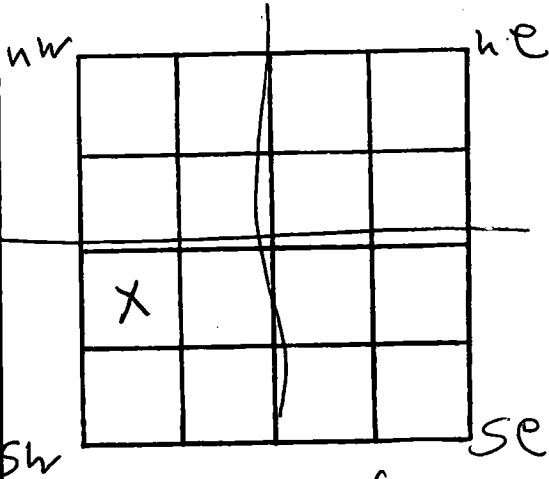

SECTION 2

Please indicate well location X.

ADDITIONAL INFORMATION

If more than one screen, show locations of each on sketch.