

HARRISON
N 283
8-10-70

MISSISSIPPI
BOARD OF WATER COMMISSIONERS
416 North State Street
Jackson, Mississippi 39201

CODED

WATER WELL DRILLERS LOG

Aug. 10 1970 19 McGill well works Harrison
date well completed firm name county well located

LANDOWNER: Bernie N. Violet
110 Penixville Road
Long Beach Miss.
(mailing address)

description of formations encountered	from	to
	top soil	0
clay	4	26
sand	26	156
clay	156	380
sand	380	345
clay	345	528
sand	528	525

WELL LOCATION:
sec. 3 T 8 N R 13 E
1 1/2 miles West of Delisle
(distance) (direction) (nearest town)

WELL PURPOSE:
(home, irrigation, municipal, industrial)

WELL COMPLETION DATA:

(1) diameter (inches) 2"

(2) total depth (feet) 525'

(3) static water level (feet) 2' below top of ground

(4) casing 2" galv (material) 10' (depth)
used if telescope see back.
(size)

(5) screen 10' (length) 56' (depth to top)
2" (size) SS (material)

(6) pump 1 (HP) 12 (yield gpm)
electric (type power)

(7) electric log No (yes or no)

(organization running log)

(8) how well bottom plugged Sand
shank

CODED


JAN 21 1971

MISS. BD. OF
WATER COMM.

DRILLERS REMARKS:

If well telescopes please sketch and show depths.

GROUND LEVEL

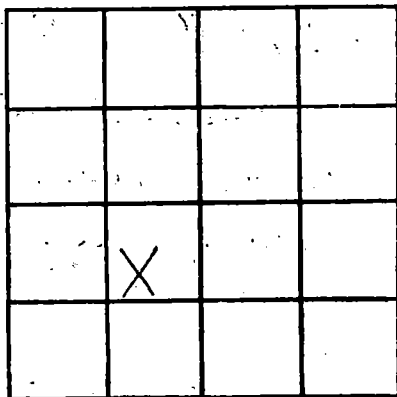

SECTION 3

Please indicate well location X.

ADDITIONAL INFORMATION

If more than one screen, show locations of each on sketch.