

HAR. MISSISSIPPI BOARD OF WATER COMMISSIONERS

N 285

a 492 206

8-27-60

WATER WELL DRILLERS LOG

CODED

Date: 8-27, 1960, Driller: H'brg Butare County Harrison
(Name)

(1) Owner of Land: N. J. Schmitt
(Name)

Cuevas Rural Sta. Cuevas, Miss
SA3T85R13W (Address)

(2) Location: 23 8512W
1/4, 1/4, Sec. T R
Jan 27 miles, of Jan 27
(distance) (direction) (Nearest Town)

(3) Topography: _____
(Hilly) (Flat) (Level)

(4) Purpose of Well: domestic
(Domestic Irrigation Municipal, Industrial, Other)

Information upon completion of well:

(1) Diameter 2" inches.

(2) Total Depth 190 feet.

(3) Water Level 7 feet below top of ground.

(4) Cased to _____, Size _____

(5) Screen: Size 2", Length 10'

(6) Were any formations sealed against pollution?
 _____ yes, X no.


If YES depth of formation _____

Why _____

Drillers Remarks: _____

Description & Color of Materials Sand, Clay, Red Clay, Shell, etc.	Thick- ness Feet	Depth Feet
yellow sand		0-20
Blue clay		20-30
blue clay yellow sand		30-40
yellow sand Blue clay		40-90
blue clay yellow sand		90-100
Blue clay		100-130
" sand		130-140
" clay		140-150
" sand		155-190

CODED

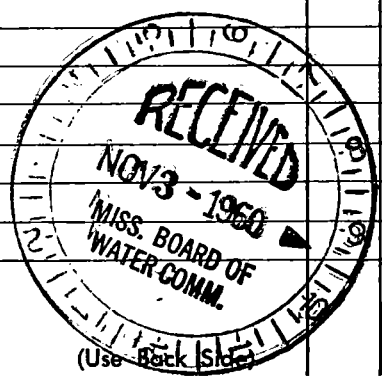

Well No. _____

0000

11
12
13
101