

Harrison
 N 290
 5-17-77

MISSISSIPPI
 BOARD OF WATER COMMISSIONERS
 416 North State Street
 Jackson, Mississippi 39201
 WATER WELL DRILLERS LOG

CODED

May 17 19 77 Sutter Well Works Harrison
 date well completed firm name county well located

LANDOWNER: Pine Point Shore
 Water Supply
 6118 Droux Avenue
 New Orleans, La. 70126
 (mailing address)

Description of formations encountered	from	to
Clay	0	9
Sand	9	18
Sand & Gravel	18	31
Clay	31	446
Fine sand	446	465
Clay	465	695
Sand	695	835

WELL LOCATION:
 sec 23 T 8 N R 13 E
 S W
 2 miles N - Pass Christian
 (distance) (direction) (nearest town)

WELL PURPOSE: sub-division
 (home, irrigation, municipal, industrial)

WELL COMPLETION DATA:
 (1) diameter (inches) 2" x 4"
 (2) total depth (feet) 835'
 (3) static water level (feet) 15' below above top of ground.
 (4) casing galv. 815'
 (material) (depth)
 2" & 4" if telescope see back.
 (size)
 (5) screen 20' 815'
 (length) (depth to top)
 2" stainless steel
 (size) (material)
 (6) pump owners
 (HP) (yield gpm)
 (type power)
 (7) electric log no
 (yes or no)
 (organization running log)
 (8) how well bottom plugged B P Valve

DRILLERS REMARKS:

RECEIVED
 JUN 20 1977

MISS. BD. OF WATER COMMISSIONERS


If well telescopes please sketch and show depths.

GROUND LEVEL

79' of 4" black steel

636' of 2" galv. steel

20' of 2" strainer

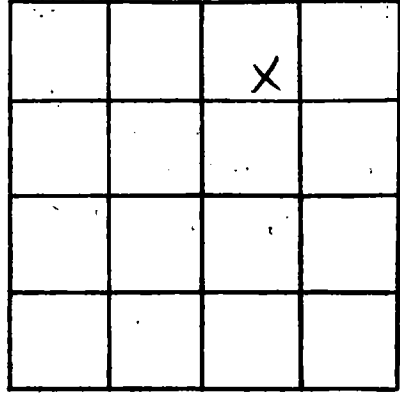

SECTION 23

Please indicate well location X.

ADDITIONAL INFORMATION

If more than one screen, show locations of each on sketch.