

HARRISON
~~HARRISON~~
 N-300
 7-18-80

MISSISSIPPI
 BOARD OF WATER COMMISSIONERS
 416 North State Street
 Jackson, Mississippi 39201

CODED

WATER WELL DRILLERS LOG

Harrison

July 18 1980 ~~Harrison Well Drilling~~ ~~Harrison~~
 date well completed firm name county well located

LANDOWNER: L. P. Lusk
1st Street Henderson
Pass Christian
 (mailing address)

description of formations encountered	from	to
Top sand	0	83
Blue clay	83	125
Gravel	125	210
Blue clay	210	300
Sand	300	340
Blue clay	340	480
Sand	480	560
Blue clay	560	791
Sand	791	840
Clay	840	850
Iron sand	850	950
Course sand	950	976

WELL LOCATION:
 sec 35 T 8 N R 13 E
On Pass Christian
 (distance) miles (direction) of (nearest town)

WELL PURPOSE: Home
 (home, irrigation, municipal, industrial)

WELL COMPLETION DATA:

(1) diameter (inches) 2"

(2) total depth (feet) 976 ft

(3) static water level (feet) 2' ^{below} above top of ground.

(4) casing Galv. (material), 976' (depth)

— (size) if telescope see back.

(5) screen 10' (length), 966' (depth to top)
2" (size), S.S. (material)

(6) pump 2 (HP), 12 (yield gpm)

— (type power)

(7) electric log — (yes or no)

— (organization running log)

(8) how well bottom plugged Sand

DRILLERS REMARKS: Owner installed gas driven pump


DEPT. OF NATURAL RESOURCES
 BUREAU OF LAND & WATER RESOURCES

SEP 22 1980

RECEIVED

070
If well telescopes please sketch and show depths.

GROUND LEVEL

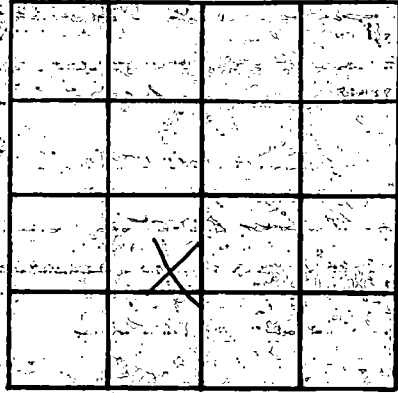

SECTION 35

Please indicate well location X.

ADDITIONAL INFORMATION

If more than one screen, show locations of each on sketch.