

MISSISSIPPI DEPARTMENT OF NATURAL RESOURCES

Bureau of Land and Water Resources

Southport Mall

P.O. Box 10631

Jackson, Mississippi 39209

WATER WELL DRILLERS LOG

CODED

HARRISON  
N-301  
8-6-80

8-6-80  
date well completed

1980 Ward Well Dlg.  
firm name

Harrison  
county well located

LANDOWNER: Mr. Fabretak  
Rt. 3, Box 778  
Pass Christian, Ms.  
(mailing address)

description of formations encountered	from	to
Top Soil - clay sd	0	20
clay - silt	20	85
fine sd	85	210
clay silt	210	236
coarse sd	236	505
	505	567

WELL LOCATION:  
sec. 8 T. 8 N. R. 13 E.  
8 4 1/2 miles N/W of Pass Christian  
(distance) (direction) (nearest town)

WELL PURPOSE: Home  
(home, irrigation, municipal, industrial)

- WELL COMPLETION DATA:
- (1) diameter (inches) 2"
  - (2) total depth (feet) 567
  - (3) static water level (feet) 1 below top of ground. above
  - (4) casing P.V.C. 557  
(material) (depth)  
(size) If telescope see back.
  - (5) screen 10' -  
(length) (depth to top)  
2" P.V.C.  
(size) (material)
  - (6) pump none -  
(HP) (yield gpm)  
(type power)
  - (7) electric log N.O.  
(yes or no)  
N.I.A.  
(organization running log)
  - (8) how well bottom plugged BWD


DRILLERS REMARKS: N/A

DEPT. OF NATURAL RESOURCES  
BUREAU OF LAND & WATER RESOURCES

SEP 10 1980  
RECEIVED

If well telescopes please sketch and show depths.

GROUND LEVEL

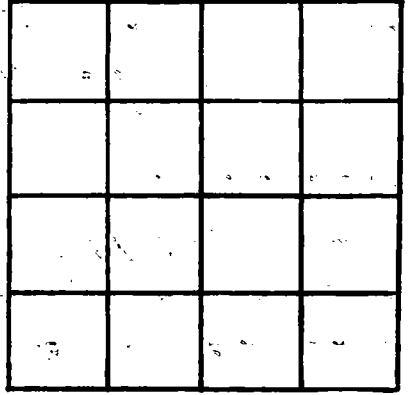

SECTION 8

Please indicate well location X.

ADDITIONAL INFORMATION

A series of horizontal lines providing space for additional information.

DES  
BU

If more than one screen, show locations of each on sketch.