

MISSISSIPPI DEPARTMENT OF NATURAL RESOURCES

Bureau of Land and Water Resources

Southport Mall

P.O. Box 10631

Jackson, Mississippi 39209

WATER WELL DRILLERS LOG

HARRISON
N 302
3-28-81

COPIED

3-28 1981
date well completed

81 Ward Well Pkg.
firm name

Harrison
county well located

LANDOWNER: Frank Ward
Arcadia Dr.
Pass Christian, ms.
(mailing address)

description of formations encountered	from	to
<u>Clay</u>	<u>0</u>	<u>10</u>
<u>sd</u>	<u>10</u>	<u>26</u>
<u>Clay-silt</u>	<u>26</u>	<u>235</u>
<u>fine sd</u>	<u>235</u>	<u>252</u>
<u>Clay-silt</u>	<u>252</u>	<u>580</u>
<u>Coarse sd</u>	<u>580</u>	<u>620</u>

WELL LOCATION:
sec. 11 T. 8 N. R. 13 E.
83± miles N/W of Pass Christian
(distance) (direction) (nearest town)

COPIED

WELL PURPOSE: Home
(home, irrigation, municipal, industrial)

WELL COMPLETION DATA:
(1) diameter (inches) 2"
(2) total depth (feet) 620
(3) static water level (feet) 5 below top of ground.
(4) casing PVC 610
(material) (depth)
(size) if telescope see back.
(5) screen 10' -
(length) (depth to top)
2" S.S.
(size) (material)
(6) pump ones -
(HP) (yield gpm)
(type power)
(7) electric log NO
(yes or no)
N/A
(organization running log)
(8) how well bottom plugged BWU

DRILLERS REMARKS: Well flowed
approx. 5 G.P.M.


DEPT. OF NATURAL RESOURCES
BUREAU OF LAND & WATER RESOURCES

APR 29 1981

RECEIVED

If well telescopes please sketch and show depths.

GROUND LEVEL

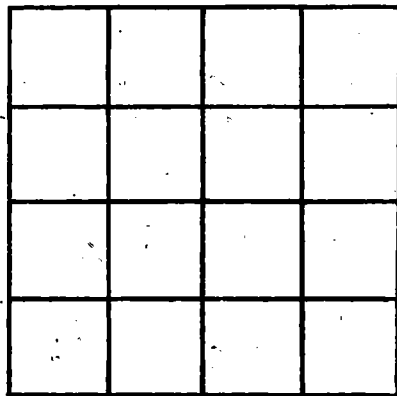

SECTION 11

Please indicate well location X.

ADDITIONAL INFORMATION

If more than one screen, show locations of each on sketch.