

MISSISSIPPI DEPARTMENT OF NATURAL RESOURCES

Bureau of Land and Water Resources

Southport Mall

P.O. Box 10631

Jackson, Mississippi 39209

WATER WELL DRILLERS LOG

COASTAL DRILLING & SERVICE CO.

ROUTE 1 BOX 618

county well located

BILOXI, MISS. 39532

Harrison  
N 303  
1-20-81



1/20/81 19  
date well completed

firm name

Harrison

LANDOWNER: Tilman H. Brown  
915 East Beach  
Post Christian Min  
(mailing address)

description of formations encountered

from to

WELL LOCATION:  
sec 26 T 8 N R 13 E  
Post Christian Min  
(distance) (direction) (nearest town)

top soil	1	3
Red Clay	3	10
Super sand	10	60
Coarse white sand	60	165
Soft blue clay	165	210
fine white sand	210	240
Soft blue clay	240	310
hard blue clay	310	490
fine white sand	490	520
fine white sand	520	560

WELL PURPOSE: Irrigation  
(home, irrigation, municipal, industrial)

WELL COMPLETION DATA:

- (1) diameter (inches) 4 1/2"
- (2) total depth (feet) 560'
- (3) static water level (feet) 20' below top of ground
- (4) casing PVC (material), 545' (depth)  
4 1/2" (size) if telescope see back.
- (5) screen 15' (length), 545' (depth to top)  
2" (size), PVC (material)
- (6) pump 3 1/2 (HP), 52 (yield gpm)  
3 1/2 (type power)
- (7) electric log no (yes or no)  
(organization running log)

(8) how well bottom plugged  
2" gravel with steel

DRILLERS REMARKS: 19-B



If well telescopes please sketch and show depths.


GROUND LEVEL

160' 4" Pit Casing

385' 2" Pit Casing

15' 2" Pit Screen

2" Gal' Wash Valve  
19-13

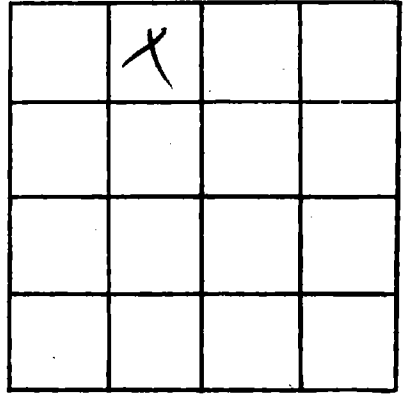

SECTION \_\_\_\_\_

Please indicate well location X.

ADDITIONAL INFORMATION

If more than one screen, show locations of each on sketch.