

HAR.

MISSISSIPPI BOARD OF WATER COMMISSIONERS

N
10-13-60

WATER WELL DRILLERS LOG

N-304

Date: 10-13, 1960, Driller: Sutter Well Works County Harrison
(Name)

(1) Owner of Land: <u>DELMORE BONNET</u> (Name)	Description & Color of Materials Sand, Clay, Red Clay, Shell, etc.	Thick- ness Feet	Depth Feet
<u>de Lisle, Miss.</u> (Address)	Clay	15	15
	red sand	45	60
(2) Location: _____ 1/4, _____ 1/4, Sec. _____ T. R. _____	Clay	365	425
_____ miles _____ of <u>de Lisle</u> , (distance) (direction) (Nearest Town)	sand	159	584
(3) Topography: <u>hilly</u> (Hilly) (Flat) (Level)	Clay	36	620
(4) Purpose of Well: <u>domestic</u> (Domestic Irrigation Municipal, Industrial, Other)	sand	95	715
	Clay	17	732
	sand	94	826
	Clay	6	832


Information upon completion of well:

- (1) Diameter 2 inches.
- (2) Total Depth 832 feet.
- (3) Water Level 24 feet above ~~below~~ top of ground.
- (4) Cased to all, Size 2"
- (5) Screen: Size 2", Length 20'
- (6) Were any formations sealed against pollution?
_____ yes, _____ no.

If YES depth of formation _____

Why _____

Drillers Remarks: _____

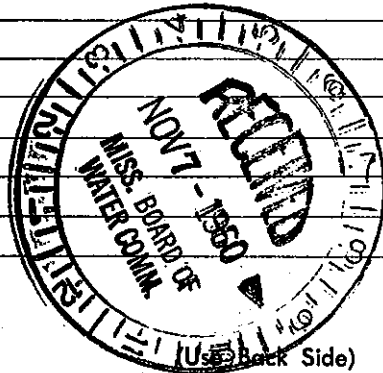

Well No.

Mail this copy to Board of Water Commissioners 429 Miss. St. Jackson, Miss